

MADISON  
M37

WATER WELL DRILLERS LOG

Date June 14, 1965, Driller: M Ka **CODED** County \_\_\_\_\_  
(Name)

(1) Owner of Land: Miss Oak Co.  
(Name)  
Center  
(Address)

(2) Location: \_\_\_\_\_ 1/4, \_\_\_\_\_ 1/4, Sec. 23 T 9 R 2  
2 miles W, of Center  
(distance) (direction) (Nearest Town)

(3) Topography: \_\_\_\_\_  
(Hilly) (Flat) (Level)

(4) Purpose of Well: Sta.  
(Domestic Irrigation  
Municipal, Industrial, Other)

Description & Color of Materials Sand, Clay, Red Clay, Shell, etc.	Thick- ness Feet	Depth Feet
<u>Top Soil</u>	<u>0</u>	<u>10</u>
<u>Blue clay</u>	<u>10</u>	<u>20</u>
<u>Blue clay</u>	<u>20</u>	<u>40</u>
<u>Shells</u>	<u>40</u>	<u>60</u>
<u>Blue clay</u>	<u>60</u>	<u>120</u>
<u>Clay</u>	<u>120</u>	<u>240</u>
<u>Shell - Sand STRA</u>	<u>240</u>	<u>280</u>
<u>Shale</u>	<u>280</u>	<u>300</u>
<u>Clay - Sand STRA</u>	<u>300</u>	<u>320</u>
<u>do do do do</u>	<u>320</u>	<u>340</u>
<u>Fine Sand</u>	<u>340</u>	<u>360</u>
<u>Med Sand</u>	<u>360</u>	<u>400</u>

Information upon completion of well:

(1) Diameter 4 1/2 inches.

(2) Total Depth 400 feet.

(3) Water Level 15 feet below top of ground.

(4) Cased to 105, Size 4.

(5) Screen: Size 007, Length 20.


(6) Were any formations sealed against pollution?  
\_\_\_\_\_ yes, ✓ no.

If YES depth of formation \_\_\_\_\_

Why \_\_\_\_\_

Drillers Remarks: \_\_\_\_\_

**CODED**

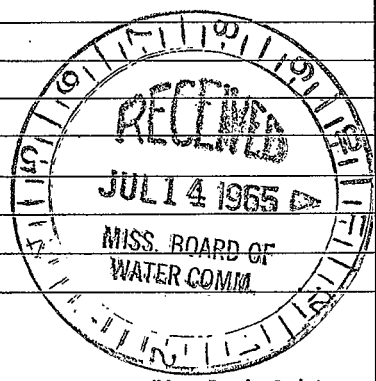

(Use Back Side)

Well No.

