

WATER WELL DRILLERS LOG

Madison
CODED

Date: 8/5, 1965, Drillers: Forest Drilling County Jeff
(Name)

(1) Owner of Land: Joe B. Hardy Jr.
(Name)
Canton, Miss
(Address)

(2) Location: 1/4, 1/4, Sec. 21 T 9 R 2E
_____ miles _____ of _____
(distance) (direction) (Nearest Town)

(3) Topography: _____
(Hilly) (Flat) (Level)

(4) Purpose of Well: Home
(Domestic Irrigation
Municipal, Industrial, Other)

Description & Color of Materials Sand, Clay, Red Clay, Shell, etc.	Thick- ness Feet	Depth Feet
<u>Brown Silt</u>	<u>8</u>	<u>8</u>
<u>Chalky Clay</u>	<u>82</u>	<u>90</u>
<u>Rock</u>	<u>153</u>	<u>92</u>
<u>Top Clay with the Silt</u>	<u>205</u>	<u>153</u>
<u>Black Clay</u>	<u>388</u>	<u>205</u>
<u>Fine Sand</u>		<u>388</u>

Information upon completion of well:

(1) Diameter 2 inches.

(2) Total Depth 388 feet.

(3) Water Level 75 feet below top of ground.

(4) Cased to 378, Size 2"

(5) Screen: Size 2", Length 10 ft


(6) Were any formations sealed against pollution?
_____ yes, _____ no.

CODED

If YES depth of formation _____

Why _____

Drillers Remarks: _____

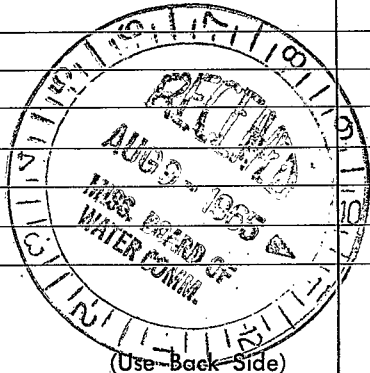

Well No.

(Use Back Side)

