

MADISON
M40
9-25-72

MISSISSIPPI
BOARD OF WATER COMMISSIONERS
416 North State Street
Jackson, Mississippi 39201

CODED

WATER WELL DRILLERS LOG

Aug-25-1972 date well completed
John A Davis firm name
Madison county well located

LANDOWNER: Leon Bouterwell
Canton, Miss.
Route - 1
(mailing address)

WELL LOCATION:
sec. 21 T. 9 N. R. 2 E
3 miles West of Canton
(distance) (direction) (nearest town)

WELL PURPOSE:
(home, irrigation, municipal, industrial)

- WELL COMPLETION DATA:
- (1) diameter (inches) 2"
 - (2) total depth (feet) 293
 - (3) static water level (feet) 70' below top of ground.
 - (4) casing gal 283' (material) (depth)
2" 8 slot (size) if telescope see back.
 - (5) screen 10' (length) (depth to top)
8 slot 2" S. Steel (size) (material)
 - (6) pump 1 Jet. 10 (HP) (yield gpm)
ELECT. (type power)
 - (7) electric log (yes or no)
 - (8) how well bottom plugged Davis

description of formations encountered	from	to
Red clay.	0	20
Gray clay.	20	62
Blue clay.	62	104
mud.	104	125
Blud.	125	188
Sand Gravel.	188	228
Sand Sand.	228	283
" "	283	293

CODED


SEP 22 1972

MISS. Bd. of
Water Comm.

DRILLERS REMARKS:

If well telescopes please sketch and show depths.

GROUND LEVEL

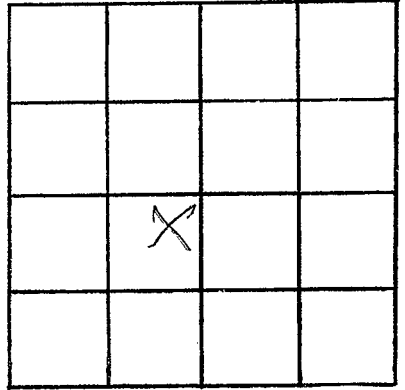

SECTION 21

Please indicate well location X.

ADDITIONAL INFORMATION

If more than one screen,
show locations of each on sketch.