

Madison
M42
1-67

MISSISSIPPI
BOARD OF WATER COMMISSIONERS
416 North State Street
Jackson, Mississippi 39201

CODED

WATER WELL DRILLERS LOG

Jan 18 1967 McKAY DRILLING MADISON
date well completed firm name county well located

LANDOWNER:
WAYMAN SOWELL
RT. 1 CANTON MISS
(mailing address)


WELL LOCATION:
sec. 22 T. 9N (N) S R. 2E (E) W
2 1/2 miles W of CANTON
(distance) (direction) (nearest town)

WELL PURPOSE: HOME
(home, irrigation, municipal, industrial)

- WELL COMPLETION DATA:
- (1) diameter (inches) 2"
 - (2) total depth (feet) 400
 - (3) static water level (feet) 30 below above top of ground.
 - (4) casing 2" Galv. (material) 390 (depth)
2" (size) if telescope see back.
 - (5) screen 1/2" Galv. (length) 390 (depth to top)
007 (size) SS (material)
 - (6) pump 1/2 (HP) 10 (yield gpm)
Elc (type power)
 - (7) electric log no. (yes or no)
none (organization running log)
 - (8) how well bottom plugged Ball

description of formations encountered	from	to
TOP SOIL	0	5
Red clay	5	10
yellow clay	10	20
blue clay	20	30
blue clay	30	120
Sand	120	140
Sandy clay	140	210
Blue clay	210	260
Reddish sand clay	260	340
Fine sand	340	360
Med Sand	360	400

CODED

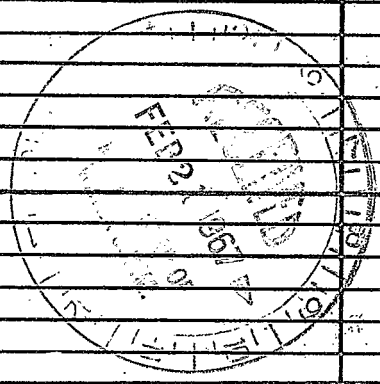

DRILLERS REMARKS:

If well telescopes please sketch and show depths.

GROUND LEVEL

	X		

SECTION 22

Please indicate well location X.

ADDITIONAL INFORMATION

If more than one screen, show locations of each on sketch.