

Madison  
M43  
6-67

MISSISSIPPI  
BOARD OF WATER COMMISSIONERS  
416 North State Street  
Jackson, Mississippi 39201

**CODED**

WATER WELL DRILLERS LOG

6/14 1967 Forest Drillers, Inc. Madison  
date well completed firm name county well located

LANDOWNER: Jeyan Inc.  
P.O. Box 1089  
Mobile, Ala.  
(mailing address)

description of formations encountered	from	to
Brown Clay		20
Clay + Sths Sand		40
Clay		76
Clay + lime rock		81
Clay + Sandy Shell		102
Clay + Sths. Mly Sand		122
Clay		143
Clay + Sths Rock		163
Clay		240
Mly Sand + Clay		260
Clay		307
Clay + Sths Mly Sand		348
Fine Sand		389
Fine Sand + Sths Clay		402
Fine Sand		414

WELL LOCATION:  
sec. 23 T 9 N R 2E E  
S W  
Interstate 55  
miles 5.5 of Centon  
(distance) (direction) (nearest town)

WELL PURPOSE: Service Station  
(home, irrigation, municipal, industrial)

WELL COMPLETION DATA:  
(1) diameter (inches) 4 X 2  
(2) total depth (feet) 410  
(3) static water level (feet) 10 below above top of ground.  
(4) casing 2 1/2" 168 ft. 4"  
(material) 2 1/2" 242 ft. 2"  
(depth)

\_\_\_\_\_ if telescope see back.  
(size)

(5) screen 20 ft. \_\_\_\_\_  
(length) (depth to top)  
2" \_\_\_\_\_  
(size) (material)  
Stainless Steel

(6) pump 1 1/2 HP - 2000 G.P.H.  
(HP) (yield gpm)  
Submersible 339 gpm  
(type power)


(7) electric log no  
(yes or no)

\_\_\_\_\_ (organization running log)

(8) how well bottom plugged backwash valve


DRILLERS REMARKS:

**CODED**

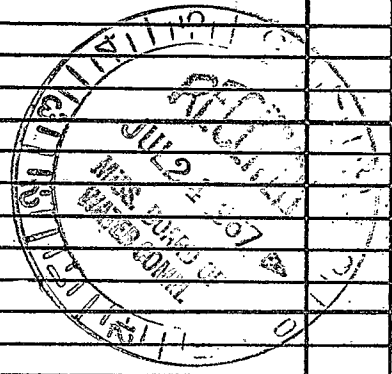

If well telescopes please sketch and show depths.

GROUND LEVEL

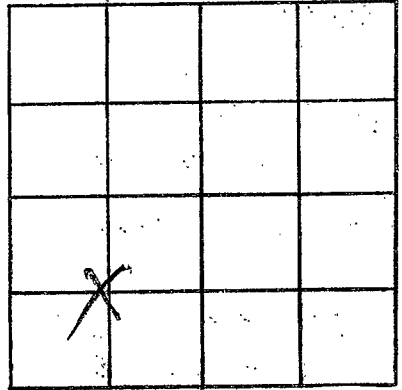

SECTION ~~28~~ (23)

Please indicate well location X.

ADDITIONAL INFORMATION

If more than one screen, show locations of each on sketch.