

MISSISSIPPI
BOARD OF WATER COMMISSIONER
416 North State Street
Jackson, Mississippi 39201

CODED

WATER WELL DRILLERS LOG

MADISON
M 44
3-66

Aug-66 19 John A DAVIS MADISON
date well completed firm name county well located

LANDOWNER Earl Holland
Canton, Miss
(mailing address)

WELL LOCATION:
sec 23 T. 9 N R. 2E
5 miles W of CANTON
(distance) (direction) (nearest town)

description of formations encountered	from	to
<u>Red clay</u>	<u>0</u>	<u>25</u>
<u>light gray clay</u>	<u>25</u>	<u>65</u>
<u>Blue mud</u>	<u>65</u>	<u>107</u>
<u>fine blue sand</u>	<u>107</u>	<u>114</u>
<u>Blue mud</u>	<u>114</u>	<u>160</u>
<u>gray sand</u>	<u>160</u>	<u>175</u>

WELL PURPOSE: Meat plant
(home, irrigation, municipal, industrial)

WELL COMPLETION DATA:

(1) diameter (inches) 2"

(2) total depth (feet) 175

(3) static water level (feet) 60 below top of ground.

(4) casing Gal 175
(material) (depth)

0 if telescope see back.
(size)

(5) screen 70' 165
(length) (depth to top)

7 slot 5.5
(size) (material)

(6) pump 1 1/2 12
(HP) (yield gpm)


Elec
(type power)

(7) electric log NO
(yes or no)

(organization running log)

(8) how well bottom plugged Topsoil
per


CODED

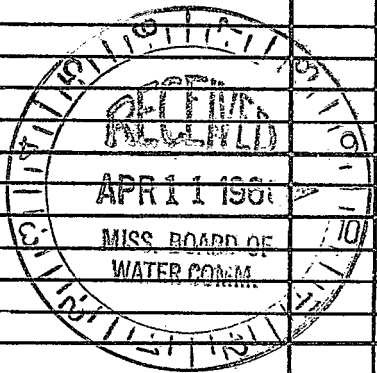

DRILLERS REMARKS:

If well telescopes please sketch and show depths.

GROUND LEVEL

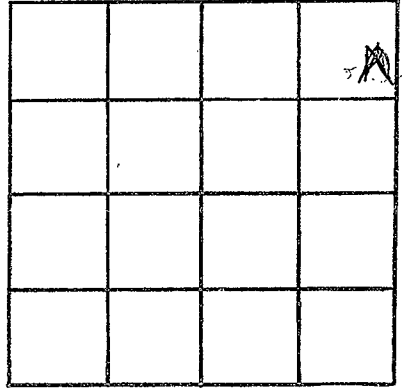

SECTION 23

Please indicate well location X.

ADDITIONAL INFORMATION

If more than one screen,
show locations of each on sketch.