

MADISON

1445

2-68

MISSISSIPPI
BOARD OF WATER COMMISSIONERS
416 North State Street
Jackson, Mississippi 39201

CODED

WATER WELL DRILLERS LOG

2-21-68 Forest Drilling Madison
date well completed 1968 firm name county well located

LANDOWNER: *Walter & Walter Farms*

description of formations encountered

from to

Rf 1

Canton, Miss.
(mailing address)

WELL LOCATION:

sec 27 T 9N R 2E
S W
3 miles South of Canton
(distance) (direction) (nearest town)

WELL PURPOSE:

(home, irrigation, municipal, industrial)

WELL COMPLETION DATA:

(1) diameter (inches) 4" X 2"

(2) total depth (feet) 410

(3) static water level (feet) 49 below top of ground

(4) casing 105' 4" (material) (depth)

290' 2" If telescope see back.
(size)

(5) screen 15' 39.5' (length) (depth to top)

2" (size) (material) (type power)

(6) pump 5 (HP) 2000 GPM (yield gpm)

Electric 33 gpm (type power)


(7) electric log No (yes or no)

(organization running log)

(8) how well bottom plugged


DRILLERS REMARKS:

CODED

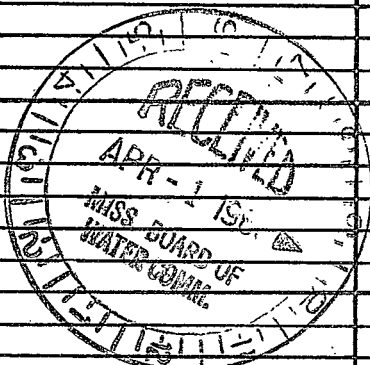

If well telescopes please
sketch and show depths.

GROUND LEVEL

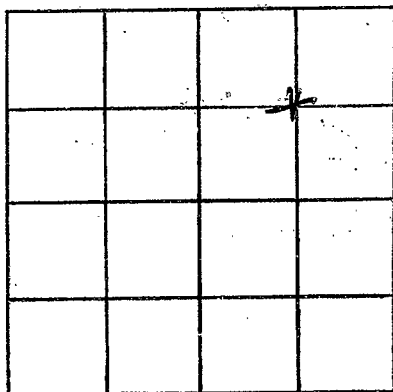

SECTION 27

Please indicate well location X.

ADDITIONAL INFORMATION

If more than one screen,
show locations of each on sketch.