

MISSISSIPPI DEPARTMENT OF NATURAL RESOURCES

Bureau of Land and Water Resources

Southport Mall

P.O. Box 10631

Jackson, Mississippi 39209

WATER WELL DRILLERS LOG

Madison
M 48
9-12-87

CODED

Griner Drilling Service, Inc.

Madison

9-12-87
 date well completed

firm name

county well located

LANDOWNER:
David New Drilling Co.
P.O. Drawer 1487
Natchez, Ms. 39120
 (mailing address)

description of formations encountered	from	to
<u>CLAY, ROCK, SAND</u>	<u>0</u>	<u>248</u>
<u>SAND</u>	<u>248</u>	<u>336</u>

WELL LOCATION: 776'S + 2150'E
 sec. 7 T. 9 N. R. 2 E of
No. 1 P. Madison Co.
Barth (direction) of Barth (nearest town)
Barth (distance) miles

776' S and 2150' E/A
NW corner

WELL PURPOSE: oilfield rig
 (home, irrigation, municipal, industrial)
supply

- WELL COMPLETION DATA:
- (1) diameter (inches) 3"
 - (2) total depth (feet) 336'
 - (3) static water level (feet) 90 below above top of ground.
 - (4) casing steel, 336'
 (material) (depth)
3" if telescope see back.
 (size)
 - (5) screen 42', 294'
 (length) (depth to top)
3", perforated
 (size) (material)
 - (6) pump AC, 70
 (HP) (yield gpm)
 (type power)
 - (7) electric log (yes or no)
 (organization running log)
 - (8) how well bottom plugged orange peel


RECEIVED
 10/19/87

Department of Natural Resources
 Bureau of Land & Water Resources

DRILLERS REMARKS:

If well telescopes please
sketch and show depths.

GROUND LEVEL

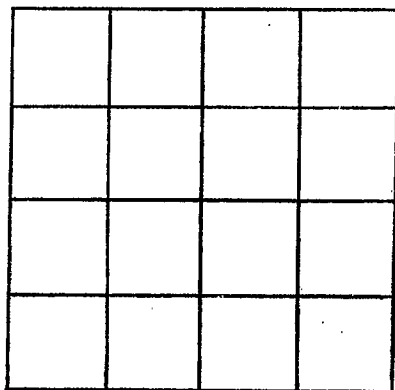

SECTION _____

Please indicate well location X.

ADDITIONAL INFORMATION

If more than one screen,
show locations of each on sketch.