

RECEIVED

Madison
 M49
 7-22-88

DEC 19 1988

Coded

WATER WELL DRILLERS LOG

Department of Natural Resources
 Bureau of Land & Water Resources

July 22 1988 date well completed
 88 Land & Water Resources
 88 Laure Central Co. firm name
 Madison county well located

LANDOWNER: Big Black Water Assoc.
6016 N. Liberty St.
Canton MS 39046
 (mailing address)

WELL LOCATION: SW 1/4 of SW 1/4
sec. 27 T. 9 N. R. 2 E.
 (distance) miles (direction) of (nearest town)

WELL PURPOSE: Municipal
 (home, irrigation, municipal, industrial)

WELL COMPLETION DATA:


- (1) diameter (inches) 12"
- (2) total depth (feet) 1956'
- (3) static water level (feet) 30' below top of ground.
- (4) casing Steel, 1815' (material), (depth)
- 12" if telescope see back.
63' of 8" (size)
- (5) screen 80', 1956' (length), (depth to top)
8", Stainless Steel (size), (material)
- (6) pump 60, 750 (HP), (yield gpm)
Electrical (type power)
- (7) electric log Yes (yes or no)
Laure-Central Co. (organization running log)
- (8) how well bottom plugged Back
Pressure Valve

description of formations encountered	from	to
Yellow Clay	0'	35'
Blue Clay	35'	150'
Sand & Clay Stbs.	150'	180'
Sandy Clay	180'	225'
Sand & Clay Stbs.	225'	2105'
Sandy Shale	2105'	340'
Sand	340'	506'
Shale	506'	630'
Yellow Clay	630'	1660'
Clay	1660'	1692'
Sand	1692'	704'
Clay & Sand Stbs.	704'	742'
Sand & Clay Stbs.	742'	762'
Clay & Sand Stbs.	762'	798'
Shale	798'	820'
Shale & Sand Stbs.	820'	8100'
Sand & Clay Stbs.	8100'	915'
Hard Clay	915'	925'
Sand	925'	976'
Clay	976'	998'
Sand	998'	1028'
Clay & Sand Stbs.	1028'	1046'
Sand & Lignite Stbs.	1046'	1126'
Sandy Clay	1126'	1220'
Clay	1220'	1334'
Hard Shale	1334'	1359'
Rock	1359'	1362'
Hard Shale	1362'	1388'
Rock	1388'	1391'
Hard Shale	1391'	1565'
Clay & Sand Stbs.	1565'	1575'
Hard Shale	1575'	1719'
Sand	1719'	1734'
Clay & Fine Sand Stbs.	1734'	1830'
Fine Sand & Clay Stbs.	1830'	18166'
Sand & Lignite Stbs.	18166'	1915'
Shale	1915'	1925'
Sand & Shale Stbs.	1925'	19161'
Shale & Sand Stbs.	19161'	2019'
Fine Sand & Shale Stbs.	2019'	2047'
Hard Shale	2047'	2056'

DRILLERS REMARKS:
Permit # MS6W-9282

If well telescopes please sketch and show depths.

GROUND LEVEL

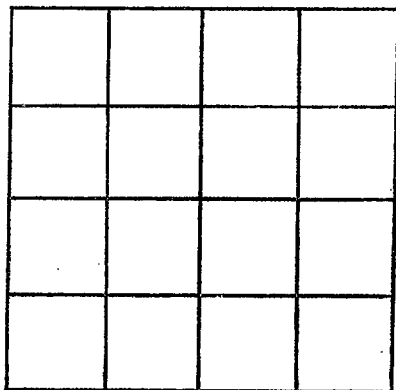

SECTION _____

Please indicate well location X.

ADDITIONAL INFORMATION

If more than one screen,
show locations of each on sketch.