


If well telescopes please sketch and show depths.

GROUND LEVEL

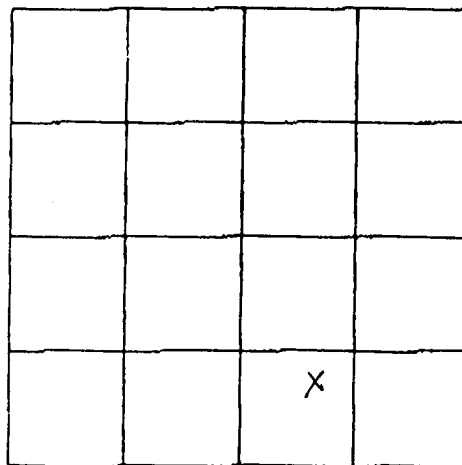

SECTION 26


Please indicate well location X.

ADDITIONAL INFORMATION

Lined area for additional information.

If more than one screen, show location of each on sketch.

MONITOR WELL NO. MW-3
 CANTON SANITARY LANDFILL
 MADISON COUNTY, MISSISSIPPI

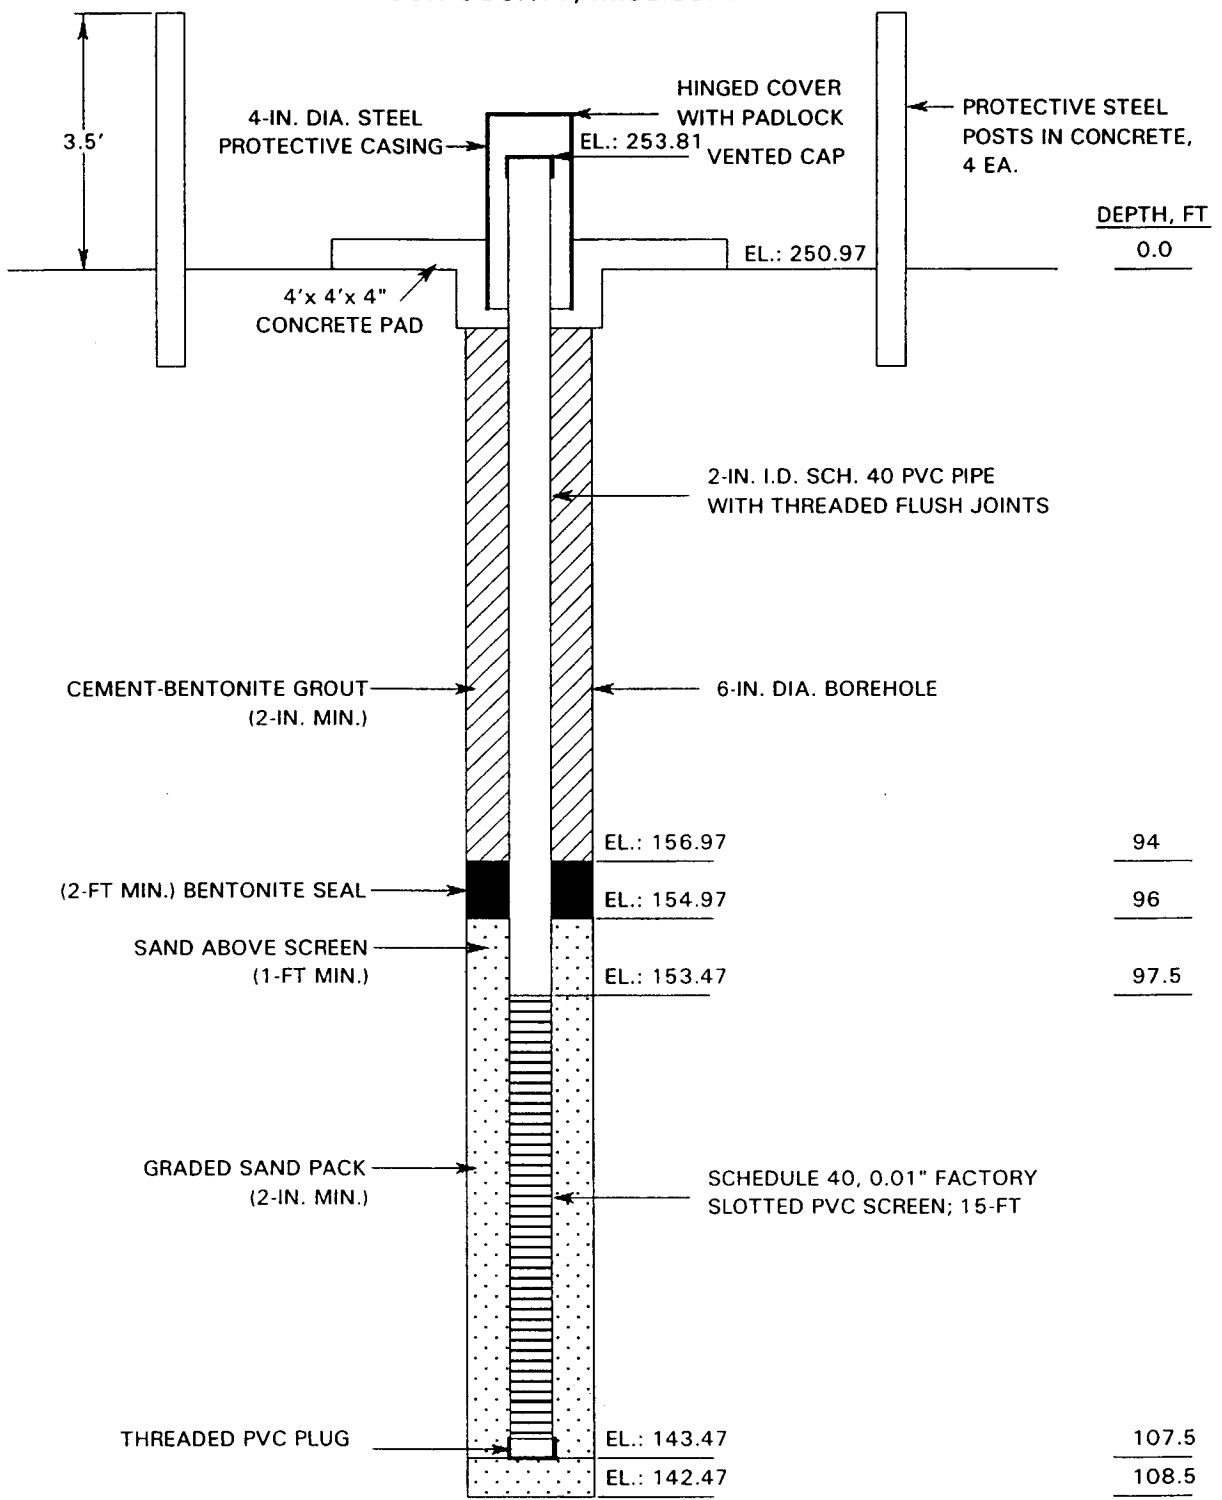

GROUNDWATER MONITORING WELL
 NOT TO SCALE

DATE INSTALLED: 5/23/96
 NOTE: SCREENED INTERVAL PLACED IN SILTY SAND (SM) OF MOODYS BRANCH FORMATION
 INSTALLER: BCD, INC.

LOG OF BORING NO. MW-3
CANTON LANDFILL
MADISON COUNTY, MISSISSIPPI

M56

TYPE: Rotary wash

LOCATION: See Figure 1

DEPTH, FT	SYMBOL	SAMPLES	DESCRIPTION OF MATERIAL	BLOWS PER FT	DRY DENSITY LBS/CU FT	Cohesion, kips/sq ft			
						1	2	3	4
			SURFACE EL: FT						
						PLASTIC LIMIT	WATER CONTENT %	LIQUID LIMIT	
						20	40	60	80
0			Very stiff tan and light gray silty clay (CL) (Loess)						
5			Very stiff tan and light gray clay (CH) (Weathered Yazoo)						
10									
15									
20									
25			Hard blue clay (CH) with fossil fragments (Unweathered Yazoo)						
30									
35									
40									
45									
50									

Continued Next Page

50881.BDS

LOG OF BORING NO. MW-3 (Continued)

M56

DEPTH, FT	SYMBOL	SAMPLES	DESCRIPTION OF MATERIAL	BLOWS PER FT	DRY DENSITY LBS/CU FT	Cohesion, kips/sq ft				
						○ - UC	○		△ - UU	
						1	2	3	4	
		+	- - - - -		+					
		20	40	60	80					
		PLASTIC LIMIT	WATER CONTENT %		LIQUID LIMIT					
105			and glauconite (Moody's Branch)							
110			Hard blue and gray silty clay (CL), cemented (Moody's Branch)							
115										
120										
125										
130										
135										
140										
145										
150										

BORING DEPTH: 108.5 FT

COMMENTS: Logged by rotary wash cuttings.

GROUNDWATER DATA: Not determined.

DATE: 5/23/96

50881 RDS