

MISSISSIPPI DEPARTMENT OF NATURAL RESOURCES

Bureau of Land and Water Resources

Southport Mall

P.O. Box 10631

Jackson, Mississippi 39209

WATER WELL DRILLERS LOG

Madison
M 2000
9-22-81

Sept. 22 1981 R.M. "Bud" Cresswell Madison
 date well completed firm name county well located

LANDOWNER:	description of formations encountered	from	to
<u>PATRICK FARMS</u> <u>CANTON, MS.</u> (mailing address)			
WELL LOCATION:			
sec. <u>20</u> T <u>9</u> N R <u>2</u> <u>E</u>			
<u>8 3/4</u> miles <u>West</u> of <u>CANTON</u> (distance) (direction) (nearest town)			
WELL PURPOSE: <u>FARM</u> (home, irrigation, municipal, industrial)			
WELL COMPLETION DATA:			
(1) diameter (inches) <u>4</u>			
(2) total depth (feet) <u>50</u>			
(3) static water level (feet) <u>30</u> below top of ground.			
(4) casing <u>PVC</u> <u>40</u> (material) (depth)			
<u>4</u> if telescope see back. (size)			
(5) screen <u>10</u> <u>40</u> (length) (depth to top)			
<u>4</u> <u>PVC</u> (size) (material)			
(6) pump <u>1</u> <u>20</u> (HP) (yield gpm)			
(type power)			
(7) electric log <u>No</u> (yes or no)			
(organization running log)			
(8) how well bottom plugged <u>SAND SHARK</u>			
DRILLERS REMARKS:			


DEPT. OF NATURAL RESOURCES
 BUREAU OF LAND & WATER RESOURCES

OCT 13 1981

RECEIVED

If well telescopes please
sketch and show depths.

GROUND LEVEL

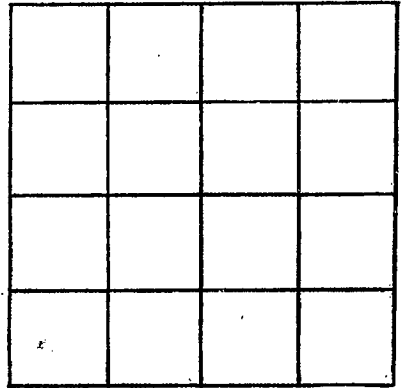

SECTION _____

Please indicate well location X.

ADDITIONAL INFORMATION

If more than one screen,
show locations of each on sketch.