

N
10-62

WATER WELL DRILLERS LOG

Date: Oct, 1962, Driller: M^r. Key County Madison
(Name)


(1) Owner of Land: <u>W. E. Howell</u> (Name)	Description & Color of Materials Sand, Clay, Red Clay, Shell, etc.	Thick- ness Feet	Depth Feet
<u>Center Miss</u> (Address)	<u>White clay</u>	<u>0</u>	<u>21</u>
(2) Location: <u>1/4</u> , <u>1/4</u> , Sec. <u>T</u> R <u>R</u>	<u>Blue clay</u>	<u>21</u>	<u>42</u>
<u>1/4</u> miles <u>S.E.</u> of <u>Center</u> (distance) (direction) (Nearest Town)	<u>Blue clay</u>	<u>42</u>	<u>45</u>
(3) Topography: <input checked="" type="checkbox"/> (Hilly) <input type="checkbox"/> (Flat) <input type="checkbox"/> (Level)	<u>Rock</u>	<u>45</u>	<u>46</u>
(4) Purpose of Well: <u>Fall out SHELFER</u> (Domestic Irrigation, Municipal, Industrial, Other)	<u>Blue Clay</u>	<u>46</u>	<u>84</u>
	<u>Brown clay</u>	<u>84</u>	<u>105</u>
	<u>1" 1.8</u>	<u>105</u>	<u>124</u>
	<u>Brown clay Sand</u>	<u>126</u>	<u>147</u>
	<u>Fine Sand</u>	<u>147</u>	<u>162</u>
	<u>Med Sand</u>	<u>168</u>	<u>189</u>
	<u>Med Sand</u>	<u>189</u>	<u>220</u>

Information upon completion of well:

- (1) Diameter 2 inches.
- (2) Total Depth 220 feet.
- (3) Water Level 31 feet below top of ground.
- (4) Cased to _____, Size _____
- (5) Screen: Size 007, Length 10
- (6) Were any formations sealed against pollution?
_____ yes, no.

If YES depth of formation _____
Why _____
Drillers Remarks: _____

Jesse Perry
Harold Perry

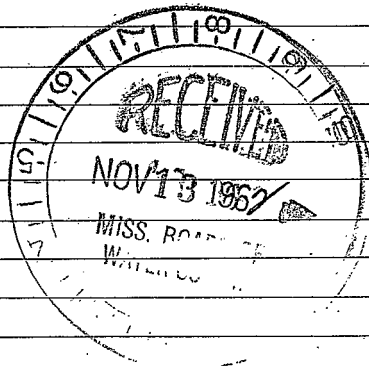

(Use Back Side)

Well No.

