

MADISON MISSISSIPPI BOARD OF WATER COMMISSIONERS

N

3-6-63

WATER WELL DRILLERS LOG

Date: 3/6, 1963, Driller: M. Kay County Madison
(Name)


	Description & Color of Materials Sand, Clay, Red Clay, Shell, etc.	Thick- ness Feet	Depth Feet
(1) Owner of Land: <u>Mary Ferguson</u> <small>(Name)</small> <u>Canton Miss</u> <small>(Address)</small>	yellow clay	0	21
	yellow clay	21	43
	Brown clay	43	84
(2) Location: <u>5</u> $\frac{1}{4}$, <u>1</u> $\frac{1}{4}$, Sec. <u> </u> T. <u> </u> R. <u> </u> <u>5</u> miles <u>NE</u> , of <u>Canton</u> <small>(distance) (direction) (Nearest Town)</small>	Black clay & Red Sta	84	105
	Black " " " "	105	210
	Sand clay	210	231
	Rock	231	238
(3) Topography: <input checked="" type="checkbox"/> (Hilly) <input type="checkbox"/> (Flat) <input type="checkbox"/> (Level)	Sandy clay	238	252
(4) Purpose of Well: <u>Home</u> <small>(Domestic Irrigation Municipal, Industrial, Other)</small>	" " " "	252	294
	Fine Sand	294	315
	Med Sand	315	360

Information upon completion of well:

- (1) Diameter 2 inches.
- (2) Total Depth 360 feet.
- (3) Water Level 83 feet below top of ground.
- (4) Cased to , Size .
- (5) Screen: Size 007, Length 10ft.
- (6) Were any formations sealed against pollution?
 yes, no.

If YES depth of formation
 Why

Drillers Remarks:

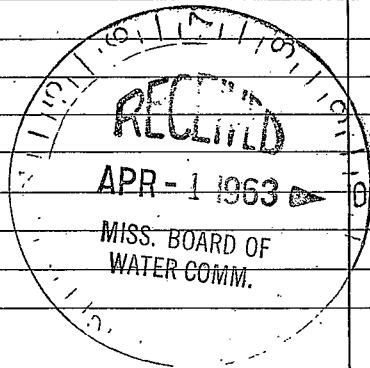

(Use Back Side)

Well No.

