

MADISON  
N 24  
6-13-69  
USGS

GW-14113  
MISSISSIPPI  
BOARD OF WATER COMMISSIONERS  
416 North State Street  
Jackson, Mississippi 39201

CODED

CODED

WATER WELL DRILLERS LOG

6-13-69 date well completed  
1969 firm name  
Layne Central Co.  
Madison county well located

LANDOWNER: Canton  
Municipal Utilities  
Canton, Miss.  
(mailing address)

WELL LOCATION:  
sec. 20 T 9 N R 3 E  
1/4 miles South of Highway 43  
(distance) (direction) (nearest town)

WELL PURPOSE: Municipal  
(home, irrigation, municipal, industrial)

WELL COMPLETION DATA:  
(1) diameter (inches) 18"  
(2) total depth (feet) 936'  
(3) static water level (feet) 68' below above top of ground.  
(4) casing Steel, 864',  
(material) (depth)  
18" and 861" by 10"  
(size) If telescope see back.  
(5) screen 60', 870'  
(length) (depth to top)  
10", Stainless Steel  
(size) (material)  
(6) pump \_\_\_\_\_ (HP) \_\_\_\_\_ (yield gpm)  
Electric  
(type power)  
(7) electric log yes  
(yes or no)  
U. S. G. S.  
(organization running log)  
(8) how well bottom plugged valve

description of formations encountered	from	to
Yellow Hummy Clay	0	20
Clay and Fine Sand	20	94
Brown Hummy Clay	94	215
Sands and Stricks of Clay	215	359
Sandy Clay	359	420
Clay	420	449
Sandy Clay	449	459
Shale	459	532
Sandy Shale	532	625
Shale and Sand	625	720
Sand Stricks of Shale	720	838
Sand	838	935
Sandy Clay	935	946
Sand	946	982
Shale	982	996

17 1969


DRILLERS REMARKS:  
Pump not installed as of this date.

MISSISSIPPI  
BOARD OF WATER COMMISSIONERS

(8)

If well telescopes please sketch and show depths.

GROUND LEVEL

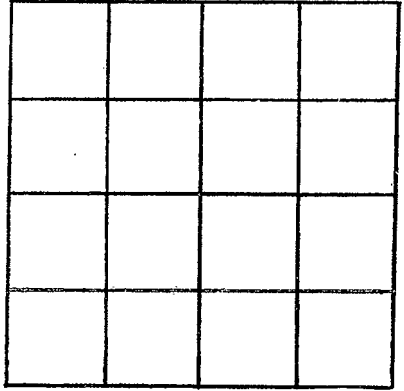

SECTION \_\_\_\_\_

Please indicate well location X.

ADDITIONAL INFORMATION

If more than one screen, show locations of each on sketch.