

MADISON
N 25
5-8-61

WATER WELL DRILLERS LOG

CODED

Date: 5/8, 1961, Driller: MCKAY DRILLERS County MADISON

(Name)

(OLD H.B. GREEN FARM)
 (1) Owner of Land: KENDDY
 (Name)
Jackson
 (Address)
 (2) Location: 1/4, 1/4, Sec. 25 T 9 R 35
4 miles E of CANTON
 (distance) (direction) (Nearest Town)
 (3) Topography: (Hilly) (Flat) (Level)
 (4) Purpose of Well: HOME
 (Domestic Irrigation
 Municipal, Industrial, Other)

Description & Color of Materials Sand, Clay, Red Clay, Shell, etc.	Thick- ness Feet	Depth Feet
yellow clay	0	21
" "	21	42
Brown clay	42	63
Blue "	63	84
" "	84	105
" "	105	126
" "	126	147
" "	147	168
" "	168	189
" "	189	210
Brown clay	210	231
" "	231	252
" "	252	273
Sand clay	273	294
" "	294	315
SAND	315	336
" "	336	357
" "	357	378
" "	378	399
SAND MED	399	400
AIR PUMP		


Information upon completion of well:

(1) Diameter 2 inches.
 (2) Total Depth 400 feet.
 (3) Water Level 60 feet below top of ground.
 (4) Cased to _____, Size _____
 (5) Screen: Size 006, Length 10ft
 (6) Were any formations sealed against pollution?
 _____ yes, no.

If YES depth of formation _____

Why _____

Drillers Remarks: _____

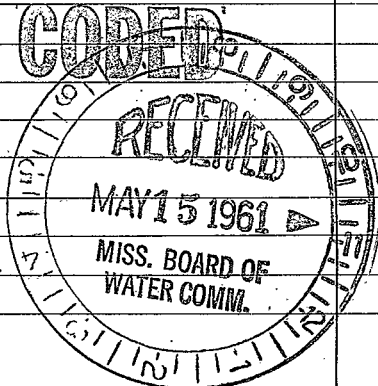

(Use Back Side)

Well No.

