

MADISON

MISSISSIPPI BOARD OF WATER COMMISSIONERS

N 27

12-22-61

WATER WELL DRILLERS LOG

CODED

Date: Dec 22, 1961, Driller: M^r. Ray Dullin County Madison
(Name)

(1) Owner of Land: <u>Gordon HART</u> (Name) <u>Canton Miss Rt 3</u> (Address) <u>9 SE</u>	Description & Color of Materials Sand, Clay, Red Clay, Shell, etc.	Thick- ness Feet	Depth Feet
(2) Location: <u>1/4</u> , <u>1/4</u> , Sec. <u>30</u> T <u>9</u> R <u>2E</u> <u>3</u> miles <u>E</u> of <u>Canton</u> (distance) (direction) (Nearest Town)	<u>White Clay</u>	<u>0</u>	<u>31</u>
(3) Topography: <input checked="" type="checkbox"/> (Hilly) <input type="checkbox"/> (Flat) <input type="checkbox"/> (Level)	<u>yellow</u>	<u>21</u>	<u>43</u>
(4) Purpose of Well: <u>Home</u> (Domestic Irrigation Municipal, Industrial, Other)	<u>Yellow Sand</u>	<u>42</u>	<u>63</u>
	<u>Blue Clay</u>	<u>63</u>	<u>84</u>
	<u>" "</u>	<u>84</u>	<u>105</u>
	<u>" "</u>	<u>105</u>	<u>126</u>
	<u>" "</u>	<u>126</u>	<u>147</u>
	<u>" "</u>	<u>147</u>	<u>168</u>
	<u>Fine Sand</u>	<u>168</u>	<u>189</u>
	<u>SAND + Clay</u>	<u>189</u>	<u>210</u>
	<u>Sand - Fine</u>	<u>210</u>	<u>231</u>
	<u>" "</u>	<u>231</u>	<u>252</u>
	<u>Sand - clay - Sta.</u>	<u>252</u>	<u>273</u>
	<u>Sand</u>	<u>273</u>	<u>294</u>
	<u>Sand</u>	<u>294</u>	<u>315</u>
	<u>Sand</u>	<u>315</u>	<u>336</u>
	<u>Sand med.</u>	<u>336</u>	<u>357</u>
	<u>Med. Sand</u>	<u>357</u>	<u>380</u>

Information upon completion of well:

(1) Diameter 2 inches.

(2) Total Depth 380 feet.

(3) Water Level 61 feet below top of ground.

(4) Cased to _____, Size SS

(5) Screen: Size 006, Length 10ft

(6) Were any formations sealed against pollution?
_____ yes, no.


If YES depth of formation _____

Why _____

Drillers Remarks: _____

10ft SS Screen
006

Running with air

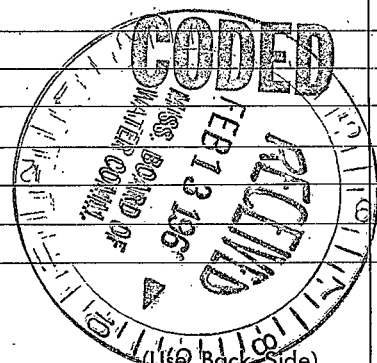

Well No. _____

