

MADISON

MISSISSIPPI BOARD OF WATER COMMISSIONERS

N28

WATER WELL DRILLERS LOG

CODED

5-5-63

Date: 5/5, 1963, Driller: M^{rs} Kay, County: Madison

(1) Owner of Land: Zebe Poole
 (Name)
Condon
 (Address)

(2) Location: 1/4, 1/4, Sec. 10 T9 R3E
3 miles NE of Condon
 (distance) (direction) (Nearest Town)

(3) Topography: (Hilly) (Flat) (Level)

(4) Purpose of Well: Home
 (Domestic Irrigation, Municipal, Industrial, Other)

Description & Color of Materials Sand, Clay, Red Clay, Shell, etc.	Thick- ness Feet	Depth Feet
<u>yellow clay</u>	<u>0</u>	<u>30</u>
<u>D. Sand clay</u>	<u>31</u>	<u>42</u>
<u>Blue clay</u>	<u>42</u>	<u>63</u>
<u>Blue clay</u>	<u>63</u>	<u>84</u>
<u>324</u>	<u>105</u>	<u>105</u>
<u>Fine Sand clay</u>	<u>105-189</u>	<u>189</u>
<u>Fine to med Sand</u>	<u>189-270</u>	<u>270</u>

Information upon completion of well:

(1) Diameter 4 inches.

(2) Total Depth 275 feet.

(3) Water Level 51 feet below top of ground.

(4) Cased to _____, Size _____

(5) Screen: Size 007, Length 10


(6) Were any formations sealed against pollution?
 _____ yes, no.

If YES depth of formation _____

Why _____

Drillers Remarks: _____

CODED

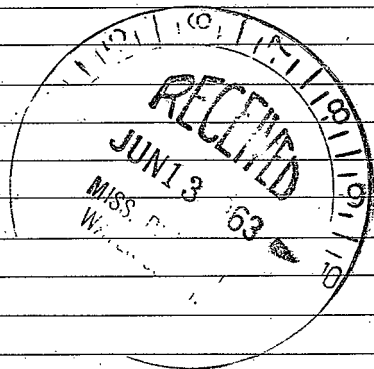

(Use Back Side)

Well No.

[The page contains extremely faint and illegible text, likely bleed-through from the reverse side of the document. No specific words or phrases can be discerned.]