

MADISON

MISSISSIPPI BOARD OF WATER COMMISSIONERS

N 29

WATER WELL DRILLERS LOG

CODED

5-10-63

Date: 5/10, 1963, Driller: M. Kay County Madison

(1) Owner of Land:

C. HAMMACK
HAMMACK
(Name)

Canton Miss
(Address)

(2) Location: 1/4, 1/4, Sec. 28 T. 9 R. 3E

3 miles SE of Canton
(distance) (direction) (Nearest Town)

(3) Topography:

(Hilly) (Flat) (Level)

(4) Purpose of Well:

Home
(Domestic Irrigation
Municipal, Industrial, Other)

Description & Color of Materials
Sand, Clay, Red Clay, Shell, etc.

Thick-
ness
Feet

Depth
Feet

yellow clay	0	21
Rock	21	24
B. loess sandy clay	24	63
Rock	63	65
Black sandy clay	65	252
Fine Sand	252	294
Fine Sand	294	315
Med Sand	315	357

Information upon completion of well:

(1) Diameter ~~2 1/2~~ 2 inches.

(2) Total Depth 357 feet.

(3) Water Level 63 feet below top of ground.

(4) Cased to _____, Size _____

(5) Screen: Size 007, Length 20 ft.

(6) Were any formations sealed against pollution?

yes, no.


If YES depth of formation _____

Why _____

Drillers Remarks: _____

air unit

CODED

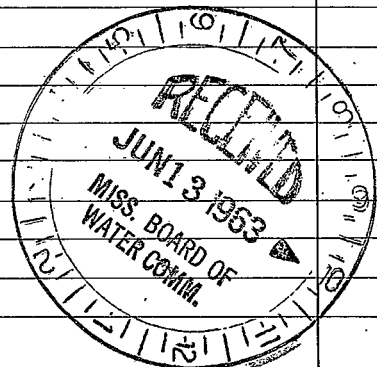

(Use Back Side)

Well No.

