

N 30

WATER WELL DRILLERS LOG

CODED

5-6-64

Date: 5/6, 1964, Driller: McKay County Madison
(Name)

(1) Owner of Land: Vernon McNeal
(Name)

Centon Miss
(Address)

(2) Location: 1/4, 1/4, Sec. 22 T 9 R 3E

3 miles E, of Centon
(distance) (direction) (Nearest Town)

(3) Topography: (Hilly) (Flat) (Level)

(4) Purpose of Well: Home
(Domestic Irrigation, Municipal, Industrial, Other)

Description & Color of Materials Sand, Clay, Red Clay, Shell, etc.	Thick- ness Feet	Depth Feet
<u>White Clay</u>	<u>0</u>	<u>20</u>
<u>Blue Clay</u>	<u>20</u>	<u>40</u>
<u>Muddy Branch</u>	<u>40</u>	<u>60</u>
<u>Blue Clay</u>	<u>60</u>	<u>100</u>
<u>Brown Clay - Lignite</u>	<u>100</u>	<u>200</u>
<u>Lignite Sand - Clay</u>	<u>200</u>	<u>240</u>
<u>Fine Sand - Clay</u>	<u>240</u>	<u>300</u>
<u>Fine Sand</u>	<u>300</u>	<u>340</u>
<u>Fine Sand</u>	<u>340</u>	<u>360</u>
<u>Med Sand</u>	<u>360</u>	<u>400</u>

Information upon completion of well:

(1) Diameter 2 inches.

(2) Total Depth 400 feet.

(3) Water Level 87 feet below top of ground.

(4) Cased to _____, Size _____

(5) Screen: Size 007, Length 15

(6) Were any formations sealed against pollution?

_____ yes, no.


If YES depth of formation _____

Why _____

Drillers Remarks: _____

CODED

Air Well

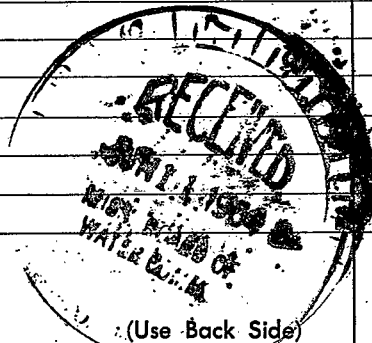

Well No.

Faint, illegible text, possibly bleed-through from the reverse side of the page.

