

MADISON
N31

MISSISSIPPI BOARD OF WATER COMMISSIONERS

8-29-64

WATER WELL DRILLERS LOG

CODED

Date: 8/29, 1964, Driller: McKany County Madison
(Name)

(1) Owner of Land: Perten Edwards
(Name)
Clinton - Miss
(Address)

(2) Location: 1/4, 1/4, Sec. 23 T9 R3E,
4 miles East of Clinton
(distance) (direction) (Nearest Town)

(3) Topography: (Hilly) (Flat) (Level)

(4) Purpose of Well: Home
(Domestic Irrigation
Municipal, Industrial, Other)

Description & Color of Materials Sand, Clay, Red Clay, Shell, etc.	Thick- ness Feet	Depth Feet
White clay	0	20
Blue clay	20	40
med Sand	40	60
" " "	60	80
Blue clay	80	100
Blue clay	100	200
Fine sand	200	220
Fine Sand	220	240
med Sand	240	280
med Sand	280	304

Information upon completion of well:

(1) Diameter 2 inches.

(2) Total Depth 304 feet.

(3) Water Level 56 feet below top of ground.

(4) Cased to _____, Size _____

(5) Screen: Size 007, Length 10

(6) Were any formations sealed against pollution?
_____ yes, no.


If YES depth of formation _____

Why _____

Drillers Remarks: _____

CODED

Red Pump
Assembled at
84 ft

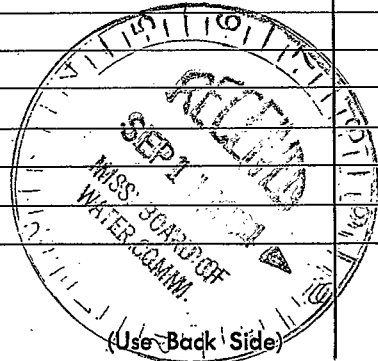

Well No. _____

22/8