

N33

3-11-65

WATER WELL DRILLERS LOG

**CODED**

Date: 3/11, 1965, Driller: M. Kay County Madison  
 (Name)

(1) Owner of Land: Perry Basche  
 (Name)  
RT 2 Canton Miss  
 (Address)

(2) Location: 1/4, 1/4, Sec. 12 T9R3E,  
6 miles E of Canton  
 (distance) (direction) (Nearest Town)

(3) Topography: ✓  
 (Hilly) (Flat) (Level)

(4) Purpose of Well: Home  
 (Domestic Irrigation  
 Municipal, Industrial, Other)

Description & Color of Materials Sand, Clay, Red Clay, Shell, etc.	Thick- ness Feet	Depth Feet
<u>Red Clay</u>	<u>0</u>	<u>20</u>
<u>Red Clay</u>	<u>20</u>	<u>40</u>
<u>Blue cl.</u>	<u>40</u>	<u>240</u>
<u>Sandy shale</u>	<u>240</u>	<u>280</u>
<u>Fine Sand</u>	<u>280</u>	<u>290</u>
<u>Clay with Sand Str.</u>	<u>290</u>	<u>300</u>
<u>Sand</u>	<u>300</u>	<u>320</u>
<u>great Sand</u>	<u>320</u>	<u>360</u>

Information upon completion of well:

(1) Diameter 2 inches.

(2) Total Depth 360 feet.

(3) Water Level 45 feet below top of ground.

(4) Cased to \_\_\_\_\_, Size \_\_\_\_\_

(5) Screen: Size 007, Length 10


(6) Were any formations sealed against pollution?  
 \_\_\_\_\_ yes, \_\_\_\_\_ no.

**CODED**

If YES depth of formation \_\_\_\_\_

Why \_\_\_\_\_

Drillers Remarks: \_\_\_\_\_

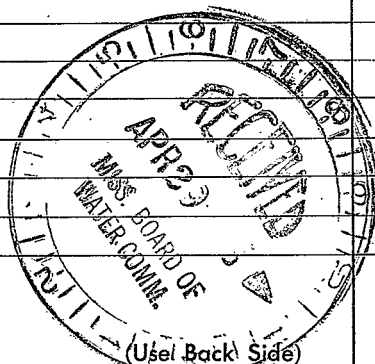

Well No.

1870

1871

1872

1873

1874