

MADISON

MISSISSIPPI BOARD OF WATER COMMISSIONERS

N34

4-5-65

WATER WELL DRILLERS LOG

CODED

Date: 4/5/65, 19, Driller: M<sup>e</sup> Kay County: Madison

(1) Owner of Land: C. Love  
 (Name)  
Canton Miss  
 (Address)

(2) Location: 1/4, 1/4, Sec. 34 T 9 R 3E,  
5 miles SE, of Canton  
 (distance) (direction) (Nearest Town)

(3) Topography:  (Hilly)  (Flat)  (Level)

(4) Purpose of Well: Home  
 (Domestic Irrigation, Municipal, Industrial, Other)

Description & Color of Materials Sand, Clay, Red Clay, Shell, etc.	Thick- ness Feet	Depth Feet
<u>white clay</u>	<u>0</u>	<u>20</u>
<u>Yellow clay</u>	<u>20</u>	<u>40</u>
<u>Blue clay</u>	<u>40</u>	<u>50</u>
<u>Blue clay</u>	<u>50</u>	<u>80</u>
<u>Blue clay</u> <u>Stew</u>	<u>80</u>	<u>160</u>
<u>Sand</u> <u>Str</u> - <u>clay</u>	<u>160</u>	<u>180</u>
<u>clay</u>	<u>180</u>	<u>200</u>
<u>Fine Sand</u> <u>Clay</u> <u>Str</u>	<u>200</u>	<u>250</u>
<u>Med Sand</u>	<u>250</u>	<u>280</u>
<u>Med Sand</u>	<u>280</u>	<u>300</u>

Information upon completion of well:

(1) Diameter 2 inches.

(2) Total Depth 300 feet.

(3) Water Level 45 feet below top of ground.

(4) Cased to \_\_\_\_\_, Size \_\_\_\_\_.

(5) Screen: Size 007, Length 10ft.


(6) Were any formations sealed against pollution?  
 \_\_\_\_\_ yes,  no.

CODED

If YES depth of formation \_\_\_\_\_

Why \_\_\_\_\_

Drillers Remarks: \_\_\_\_\_

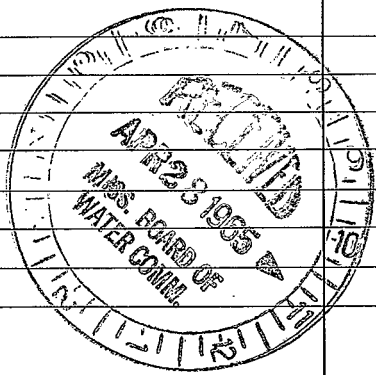

(Use Back Side)

Well No.

