

Madison
 N 40
 2-67

MISSISSIPPI
 BOARD OF WATER COMMISSIONERS
 416 North State Street
 Jackson, Mississippi 39201

CODED

WATER WELL DRILLERS LOG

Feb 17 19 67 McKay Drills Madison
 date well completed firm name county well located

LANDOWNER:
 Mrs Anna Lee
 Rt 1 Canton miss
 (mailing address)

description of formations encountered	from	to
Yellow clay	1	16
Shale	16	20
Green Bank	20	40
Blue clay	40	120
Green clay	120	200
Shale - Sand	200	250
Fine Sand	250	260
Fine Sand - Blue Shale	260	280
Med Sand	280	300
Med Sand	300	300
Clay	300	305


WELL LOCATION:
 sec 6 T 9 N R 3 E
 S W
 3 miles N of Canton
 (distance) (direction) (nearest town)

WELL PURPOSE: Home
 (home, irrigation, municipal, industrial)

WELL COMPLETION DATA:

(1) diameter (inches) 2"
 (2) total depth (feet) 304
 (3) static water level (feet) 46 below above top of ground.
 (4) casing Galv, 294 (material) (depth) 2" (size) If telescope see back.
 (5) screen 10ft, 274 (length) (depth to top) .007, S.S. (size) (material)
 (6) pump 3/4 8 (HP) (yield gpm) Eln Jet Pump (type power)
 (7) electric log no (yes or no)
 (organization running log)
 (8) how well bottom plugged Wash Valve

CODED

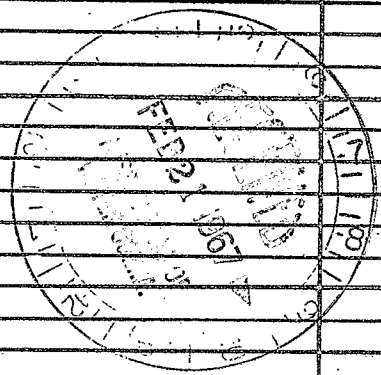

DRILLERS REMARKS:

If well telescopes please sketch and show depths.

GROUND LEVEL

			X

SECTION 6

Please indicate well location X.

ADDITIONAL INFORMATION

If more than one screen, show locations of each on sketch.