

Madison
 N 41
 4-67

MISSISSIPPI
 BOARD OF WATER COMMISSIONERS
 416 North State Street
 Jackson, Mississippi 39201

WATER WELL DRILLERS LOG

4/12/67 date well completed
 Fresh Drilling, Inc. firm name
 Madison county well located

LANDOWNER: Simon Dubrey
Canton, Miss.
 (mailing address)

description of formations encountered	from	to
Brown Clay	0	35
Blue Clay + Shell		40
Sandy Shell		61
red. Sand + Shell		81
Drift Sand		93
Clay		143
Clay + Fine Sand		204
Fine Sand + Clay		244
Fine Sand		265
Clay + 5th Sand		285
Red. Sand + 5th Clay		307
Fine Sand		346


WELL LOCATION:
 sec. 21 T 9 N R 3 E
2 miles 3/8 E of Canton
 (distance) (direction) (nearest town)

WELL PURPOSE: Home
 (home, irrigation, municipal, industrial)

WELL COMPLETION DATA:


- (1) diameter (inches) 2"
- (2) total depth (feet) 346
- (3) static water level (feet) 33 ^{below} _{above} top of ground.
- (4) casing Galv. 336
 (material) (depth)
2" if telescope see back.
 (size)
- (5) screen 10ft 336
 (length) (depth to top)
2" Galv. Brass
 (size) (material)
- (6) pump _____ (HP) _____ (yield gpm)
 (type power)
- (7) electric log No
 (yes or no)
 (organization running log)
- (8) how well bottom plugged backwash
value

DRILLERS REMARKS: customer
Installed on pump

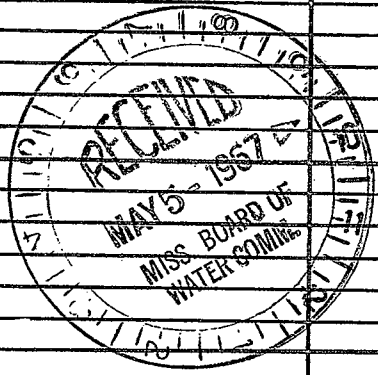

If well telescopes please sketch and show depths.

GROUND LEVEL

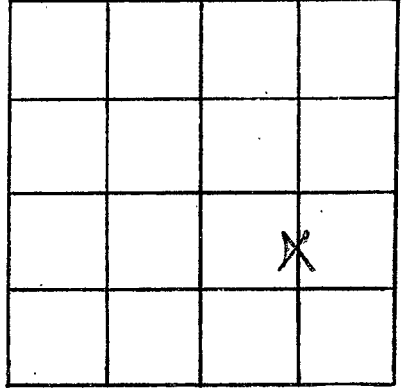

SECTION 27

Please indicate well location X.

ADDITIONAL INFORMATION

If more than one screen,
show locations of each on sketch.