

MADISON  
 N 43  
 2-11-75

MISSISSIPPI  
 BOARD OF WATER COMMISSIONERS CODED  
 416 North State Street  
 Jackson, Mississippi 39201

WATER WELL DRILLERS LOG

Feb-11 1975 John A Davis Madison  
 date well completed firm name county well located

LANDOWNER: Milton Carl

Canton Miss

(mailing address)

WELL LOCATION:

sec. 16 T 9 N R 3 E  
 2 miles North of Canton  
 (distance) (direction) (nearest town)

WELL PURPOSE:

(home, irrigation, municipal, industrial)

WELL COMPLETION DATA:

(1) diameter (inches) 2"

(2) total depth (feet) 210

(3) static water level (feet) 70 below top of ground.

(4) casing PVC 200  
 (material) (depth)

(size) if telescope see back.

(5) screen 10' 200  
 (length) (depth to top)

10' PVC  
 (size) (material)

(6) pump 1 H.P. 10  
 (HP) (yield gpm)


(type power)

(7) electric log  (yes or no)

(organization running log)

(8) how well bottom plugged fine

description of formations encountered	from	to
light clay	0	50
Blue muds	50	90
	90	105
Blue	105	130
Sand streaks	130	175
Sand	175	210

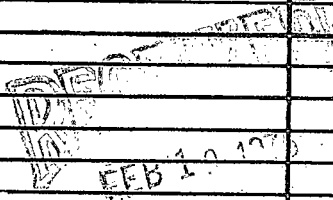


DRILLERS REMARKS:

Good Drilling

MISS. BD. 01

If well telescopes please sketch and show depths.

GROUND LEVEL

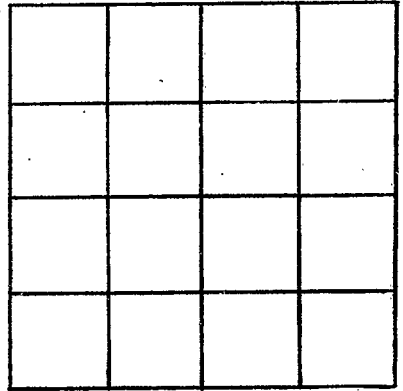

SECTION \_\_\_\_\_

Please indicate well location X.

ADDITIONAL INFORMATION

If more than one screen, show locations of each on sketch.