

MADISON
N-45

MISSISSIPPI
BOARD OF WATER COMMISSIONERS
416 North State Street
Jackson, Mississippi 39201

CODED

2-6-80

WATER WELL DRILLERS LOG

2-6
date well completed

1980 Thomas G. Sew
firm name

MADISON
county well located

LANDOWNER: L. M. KOPNER
43 South
Canton, Ms
(mailing address)

description of formations encountered	from	to
Dirt	0	15
fine clay	15	25
Blue chalk	25	40
Rock Hard	45	57
Green Sand & chalk	40	100
Greish SAND & Chalk	100	160
Chalk Mostly	160	190
Mostly Sand Good	190	326
At Bottom		

WELL LOCATION:
sec. 33 T 90 N R 3 E
2 miles SE of Canton
(distance) (direction) (nearest town)

WELL PURPOSE:
(home, irrigation, municipal, industrial)

WELL COMPLETION DATA:

(1) diameter (inches) 2

(2) total depth (feet) 326

(3) static water level (feet) 60 below top of ground.

(4) casing PVC 306 (material) (depth)

2 If telescope see back. (size)

(5) screen 20 306 (length) (depth to top)

2" PVC 10 slot (size) (material)

(6) pump 2 25 (HP) (yield gpm)

Air Comp. elec. (type power)

(7) electric log NP (yes or no)

(organization running log)

(8) how well bottom plugged Point

CODED

DEPT. OF NATURAL RESOURCES
BUREAU OF LAND & WATER RESOURCES


APR 21 1980

RECEIVED

DRILLERS REMARKS:

If well telescopes please sketch and show depths.

GROUND LEVEL

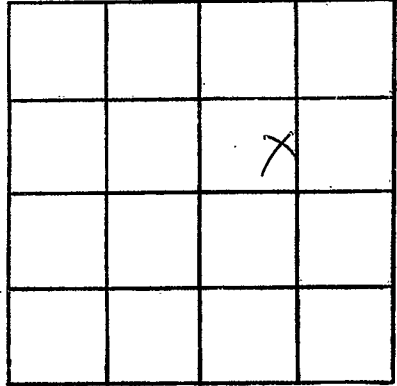

SECTION 33

Please indicate well location X.

ADDITIONAL INFORMATION

If more than one screen, show locations of each on sketch.