

MADISON

MISSISSIPPI BOARD OF WATER COMMISSIONERS

~~MS-6W-14511~~

MS-46

**CODED**

5-14-63

**WATER WELL DRILLERS LOG**

MS-6W-14511

Date: 5-14-1963, Driller: Layne-Central Co. County: Madison

(Name)

	Description & Color of Materials Sand, Clay, Red Clay, Shell, etc.	Thick- ness Feet	Depth Feet
(1) Owner of Land: <u>Public Utility Comm.</u> (Name) <u>Canton, Mississippi</u> (Address)	cinders	1	0
(2) Location: <u>NE 1/4, NE 1/4, Sec. 25 T9 R2E</u>  _____ miles _____ of _____ (distance) (direction) (Nearest Town)	yellow clay	19	20
(3) Topography: _____ (Hilly) (Flat) (Level)	brittle clay	13	33
(4) Purpose of Well: <u>Municipal</u> (Domestic Irrigation Municipal, Industrial, Other)	blk. sand & shells	47	80
	sandy clay	20	100
	sandy clay shells & clay	40	240
	sand	16	356
	sand & clay stks	77	433
	sandy clay	42	575
	find sand	15	590
	sandy clay stks of clay	38	728
	shale sandy stks	22	750
	fine sand & shale	41	791
	fine H.P. sand	34	825
	sandy shale	8	833
	pk. sand	38	970
	sand & stks shale	13	983

Information upon completion of well:

(1) Diameter 18 1/2 inches.

(2) Total Depth 974 feet.

(3) Water Level 50 feet below top of ground.

(4) Cased to 901', Size 18"

(5) Screen: Size 10", Length 60'

(6) Were any formations sealed against pollution?


yes,  no.

If YES depth of formation 901' and

Why required

Drillers Remarks:

**CODED**

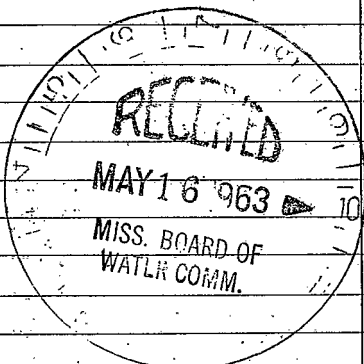

(Use Back Side)

Well No.

②