

MISSISSIPPI DEPARTMENT OF NATURAL RESOURCES  
 Bureau of Land and Water Resources  
 Southport Mall  
 P.O. Box 10631  
 Jackson, Mississippi 39209  
**WATER WELL DRILLERS LOG**

Madison  
N  
2000

8-3 1983 Thomas + Sd Madison Co  
 date well completed firm name county well located

LANDOWNER:	description of formations encountered	from	to
<u>Clifton Goodlow</u> <u>Sharon Miss</u> (mailing address)	<u>Red Dirt</u>	<u>0</u>	<u>6</u>
	<u>Red sand</u>	<u>6</u>	<u>20</u>
	<u>Grey Chalk</u>	<u>20</u>	<u>60</u>
	<u>Grey sand &amp; chalk</u>	<u>60</u>	<u>78</u>
	<u>Course W. Sand</u>	<u>78</u>	<u>103</u>
<b>WELL LOCATION:</b> sec. <u>23</u> T. <u>90</u> N. R. <u>30</u> E. <u>5</u> miles <u>South</u> of <u>Sharon</u> (distance) (direction) (nearest town)			
<b>WELL PURPOSE:</b> (home, irrigation, municipal, industrial)			
<b>WELL COMPLETION DATA:</b>			
(1) diameter (inches) <u>2"</u>			
(2) total depth (feet) <u>103'</u>			
(3) static water level (feet) <u>24'</u> <u>below</u> top of ground.			
(4) casing <u>PVC</u> , <u>103'</u> (material) (depth)			
<u>2"</u> if telescope see back. (size)			
(5) screen <u>10'</u> , <u>93'</u> (length) (depth to top)			
<u>2"</u> , <u>PVC</u> (size) (material)			
(6) pump <u>1</u> , <u>8</u> (HP) (yield gpm)			
<u>Electric</u> (type power)			
(7) electric log <u>NO</u> (yes or no)			
(organization running log)			
(8) how well bottom plugged <u>Screen</u>			
<b>DRILLERS REMARKS:</b>			


DEPT. OF NATURAL RESOURCES  
 BUREAU OF LAND & WATER RESOURCES

AUG 24 1983

RECEIVED

If well telescopes please sketch and show depths.

GROUND LEVEL

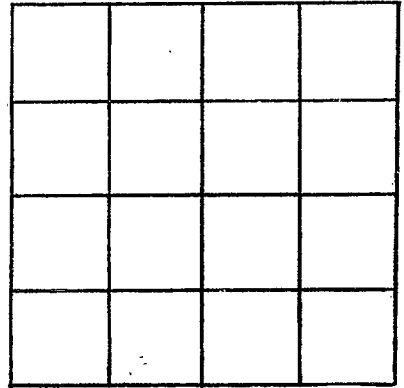

SECTION \_\_\_\_\_

Please indicate well location X.

ADDITIONAL INFORMATION

If more than one screen,  
show locations of each on sketch.