

WATER WELL DRILLERS LOG

8-2-62

Date: Aug 2, 1962, Driller: M. C. Kay

County: MADISON

(1) Owner of Land: Sharon Summerlin

(Address) 7 4, 9 9 SE

(2) Location: 1/4, 1/4, Sec. 33 T10 R5E, 14 miles E of Canton

(3) Topography: (Hilly) (Flat) (Level)

(4) Purpose of Well: Home (Domestic Irrigation, Municipal, Industrial, Other)

Description & Color of Materials Sand, Clay, Red Clay, Shell, etc.	Thick- ness Feet	Depth Feet
White Clay	0	21
Yellow Clay	21	42
Brown Clay	42	63
" "	63	105
Brown Clay - Sand	105	168
Fine Sand	168	189
" "	189	209
Rock	209	210
Rock str - Clay - Sand	210	294
Clay - Sand	294	336
Rock - Sand - Clay	336	378
Light - Sand	378	399
Sandy Clay	399	441
" "	441	462
Med - Sand	462	483
Sand - Clay STA	483	504
" "	504	525
Fine to MED SAND	525	568

Information upon completion of well:

(1) Diameter 2 inches.

(2) Total Depth 568 feet.

(3) Water Level 109 feet below top of ground.

(4) Cased to _____, Size _____

(5) Screen: Size 200, Length 20


(6) Were any formations sealed against pollution? yes, no.

If YES depth of formation _____

Why _____

Drillers Remarks: _____

3 HP. air pump
336 ft air line

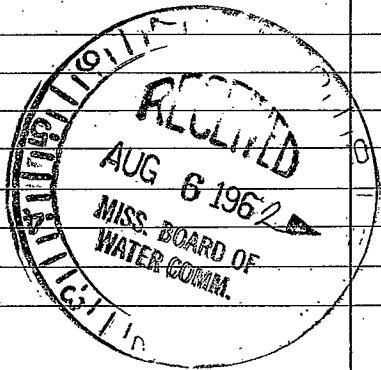

(Use Back Side)

Well No.

