

WATER WELL DRILLERS LOG

Date: 5/6, 1966, Driller: M. Kay County Madison
(Name)

(1) Owner of Land: Ralph Cain
(Name)
Shawnee Miss
(Address)

(2) Location: 1/4, 1/4, Sec. T R
7 miles E, of Shawnee
(distance) (direction) (Nearest Town)

(3) Topography: (Hilly) (Flat) (Level)

(4) Purpose of Well: Home
(Domestic Irrigation Municipal, Industrial, Other)

Description & Color of Materials Sand, Clay, Red Clay, Shell, etc.	Thick- ness Feet	Depth Feet
<u>Red Clay</u>	<u>0</u>	<u>10</u>
<u>white sand</u>	<u>10</u>	<u>20</u>
<u>Sandy clay</u>	<u>20</u>	<u>40</u>
<u>White clay</u>	<u>40</u>	<u>80</u>
<u>Brown clay</u>	<u>80</u>	<u>100</u>
<u>Sandy clay</u>	<u>100</u>	<u>120</u>
<u>sand</u>	<u>120</u>	<u>140</u>
<u>Med Sand</u>	<u>140</u>	<u>150</u>

Information upon completion of well:

(1) Diameter 2 inches.

(2) Total Depth 150 feet.

(3) Water Level 08 feet below top of ground.

(4) Cased to _____, Size _____

(5) Screen: Size 007, Length 10


(6) Were any formations sealed against pollution?
 _____ yes, _____ no.

air unit

If YES depth of formation _____

Why _____

Drillers Remarks: _____

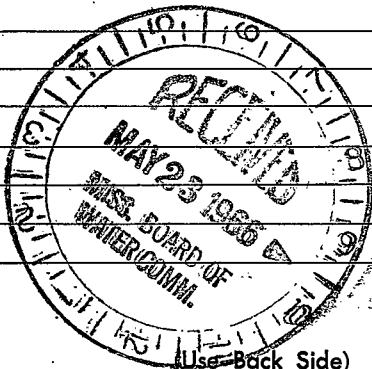

Well No.

