

Madison
0

MISSISSIPPI
BOARD OF WATER COMMISSIONERS
416 North State Street
Jackson, Mississippi 39201

WATER WELL DRILLERS LOG

10/20 1982
date well completed

Thomas & Son
firm name

Madison
county well located

LANDOWNER: Steve Colston
RT 2
Canton MISS
(mailing address)

WELL LOCATION:
sec. 21 T 9 N R 4 E
S W
miles of
(distance) (direction) (nearest town)

WELL PURPOSE:
(home, irrigation, municipal, industrial)

WELL COMPLETION DATA:
(1) diameter (inches) 2"
(2) total depth (feet) 200
(3) static water level (feet) 60 below top of ground.
(4) casing PVC 200 (material) (depth) 2" (size) If telescope see back.
(5) screen 10' 190' (length) (depth to top) 2 (size) PVC (material)
(6) pump 1 (HP) 8 (yield gpm) Electric (type power)
(7) electric log NU (yes or no)
(organization running log)
(8) how well bottom plugged Screen

description of formations encountered	from	to
Red dirt	0	8
Blue-Gray Chalk	8	36
White Sand	36	40
Blue Chalk	40	60
Grey sand & some chalk	60	80
Grey Chalk	80	138
Grey Sand	138	145
Grey Chalk	145	152
Grey Sand & Chalk	152	160
Grey Sand	160	200

DRILLERS REMARKS:


DEPT. OF NATURAL RESOURCES
BUREAU OF LAND & WATER RESOURCES

NOV 15 1982

RECEIVED

If well telescopes please sketch and show depths.

GROUND LEVEL

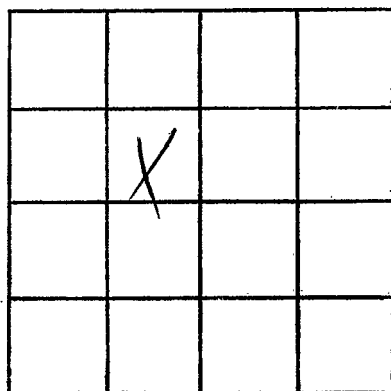

SECTION _____

Please indicate well location X.

ADDITIONAL INFORMATION

If more than one screen,
show locations of each on sketch.