

CC 12 F

MISSISSIPPI BOARD OF WATER COMMISSIONERS  
416 North State Street  
Jackson, Mississippi 39201

**CODED**

Madison  
Ø 18  
1-28-70

WATER WELL DRILLERS LOG

date well completed 1/28 1970 firm name Forest Drilling county well located Madison

LANDOWNER: Pearl River Water Supply District  
Reelfoot Ferry - Madison Co.  
(mailing address)

description of formations encountered	from	to
Clay	0	10
Red clay	10	20
Clay	20	60
fine sand	60	70
Clay & silt sand	70	140
Clay	140	260
Clay & silt sand	260	280
fine sand	280	290
fine sand & silt clay	290	302
Mucky clay	302	342

WELL LOCATION:  
sec. 25 T 9 N R 43 E  
15 miles E of Canton  
(distance) or (direction) of (nearest town)  
or Harley Place

WELL PURPOSE: Community  
(home, irrigation, municipal, industrial)

WELL COMPLETION DATA:

- (1) diameter (inches) 4" x 2"
- (2) total depth (feet) 314'
- (3) static water level (feet) 37' below above top of ground.
- (4) casing Steel, 294'  
(material) (depth) 193'-4"  
4" x 2" If telescope see back. 221'-2"  
(size)
- (5) screen 30', 294'  
(length) (depth to top)  
2", Stainless Steel - cas  
(size) (material)
- (6) pump 2-19 Stage 24  
(HP) (yield gpm)  
Electric  
(type power)
- (7) electric log yes  
Miss. (yes or no)  
Geological  
(organization running log)
- (8) how well bottom plugged 2"  
Backwash Valve

**CODED**  
**CODED**  
**CODED**


FEB 27 1970

MISS. DE. OF WATER SUPPLY

DRILLERS REMARKS: 18'-2"  
tail pipe under screen

If well telescopes please sketch and show depths.

GROUND LEVEL

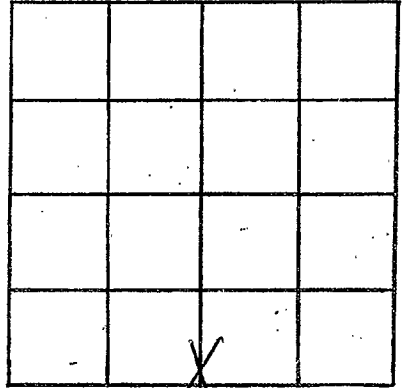

SECTION 25

Please indicate well location X.

ADDITIONAL INFORMATION

If more than one screen,  
show locations of each on sketch.