

① 30  
4-24-63

SPT

WATER WELL DRILLERS LOG

CODED

Date: 4/24, 1963, Driller: M. E. Ray (Name) County: Madison

| (1) Owner of Land:  | Description & Color of Materials<br>Sand, Clay, Red Clay, Shell, etc. | Thick-<br>ness<br>Feet | Depth<br>Feet |
|---|---|------------------------|---------------|
| (Name) <u>Frank Johnson</u><br>(Address) <u>Sharon Moor</u>                               | <u>White Sandy Clay</u>   | 0                      | 21            |
| (2) Location: _____ 1/4, _____ 1/4, Sec. <u>1</u> T. <u>9</u> R. <u>4E</u>                | <u>Brown clay</u>   | 21                     | 42            |
| <u>9</u> miles <u>E</u> , of <u>Centerville</u><br>(distance) (direction) (Nearest Town)  | <u>Brown clay - Sandy</u>   | 42                     | 126           |
| (3) Topography: _____<br>(Hilly) (Flat) (Level)   | <u>Sea Shells</u>   | 126                    | 168           |
| (4) Purpose of Well: <u>Home</u><br>(Domestic Irrigation<br>Municipal, Industrial, Other) | <u>Brown Sandy Clay</u>   | 168                    | 210           |
|   | <u>Rock</u>   | 210                    | 294           |
|   | <u>Brown clay</u>   | 294                    | 295           |
|   | <u>Fine sand</u>  | 295                    | 357           |
|   | <u>Med to coarse sand</u>   | 357                    | 483           |

Information upon completion of well:

- (1) Diameter 2 1/2 x 2 inches.
- (2) Total Depth 548 feet.
- (3) Water Level 68 feet below top of ground.
- (4) Cased to \_\_\_\_\_, Size \_\_\_\_\_
- (5) Screen: Size 607, Length 20ft
- (6) Were any formations sealed against pollution?  
\_\_\_\_\_ yes,  no.


If YES depth of formation \_\_\_\_\_

Why \_\_\_\_\_

Drillers Remarks: \_\_\_\_\_

3HP air unit

CODED

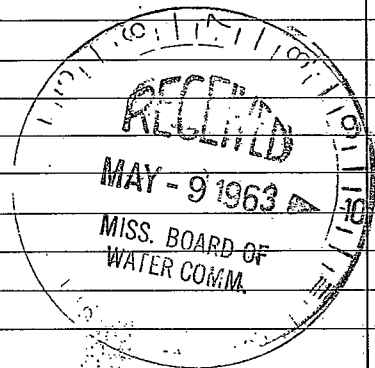

(Use Back Side)

Well No.

