

MADISON

MISSISSIPPI BOARD OF WATER COMMISSIONERS

031

7-17-63

WATER WELL DRILLERS LOG

CODED

Date: July 17, 1963 Driller: M. Kay County: Madison

(1) Owner of Land:	Description & Color of Materials Sand, Clay, Red Clay, Shell, etc.	Thick- ness Feet	Depth Feet
J. N. Steen (Name) Canton, Miss. (Address)	Red Sand	0	21
(2) Location: 1/4, 1/4, Sec. 23 T 9 R 4E	Blue Clay	21	42
10 miles S E of Canton (distance) (direction) (Nearest Town)	Brown Sandy clay	42	105
(3) Topography: <input checked="" type="checkbox"/> (Hilly) <input type="checkbox"/> (Flat) <input type="checkbox"/> (Level)	Sandy clay	105	189
(4) Purpose of Well: Home (Domestic Irrigation, Municipal, Industrial, Other)	Med. Sand	189	294
	Med. Sand	294	315
	3HP air well	315	327

Information upon completion of well:

(1) Diameter 2 inches.

(2) Total Depth 327 feet.

(3) Water Level 87 feet below top of ground.

(4) Cased to _____, Size _____

(5) Screen: Size 107, Length 10


(6) Were any formations sealed against pollution?
 _____ yes, no.

If YES depth of formation _____

Why _____

Drillers Remarks: _____

CODED

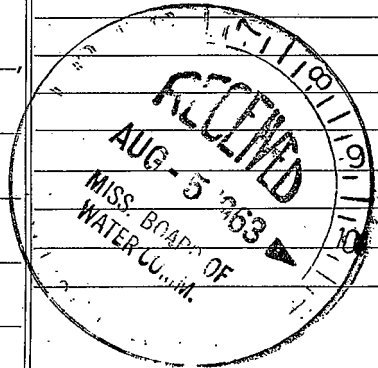

(Use Back Side)

Well No.

