

MADISON MISSISSIPPI BOARD OF WATER

Ø33

6-8-64

WATER WELL DRILLERS

CODED

Date 6/8, 1964, Driller: M. Kay
(Name)

County Madison

(1) Owner of Land: Melvin Steen
(Name)

Sharon Mair
(Address)

(2) Location: 1/4, 1/4, Sec. 6 T 9 R 9 E

6 miles East, of Ponton
(distance) (direction) (Nearest Town)

(3) Topography: (Hilly) (Flat) (Level)

(4) Purpose of Well: Home
(Domestic Irrigation, Municipal, Industrial, Other)

Description & Color of Materials Sand, Clay, Red Clay, Shell, etc.	Thick- ness Feet	Depth Feet
<u>Top Soil</u>	<u>0</u>	<u>10</u>
<u>Red Sand</u>	<u>10</u>	<u>20</u>
<u>White clay</u>	<u>20</u>	<u>40</u>
<u>Sand</u>	<u>40</u>	<u>60</u>
<u>Sand</u>	<u>60</u>	<u>80</u>
<u>Sand</u>	<u>80</u>	<u>100</u>
<u>Sand Red</u>	<u>100</u>	<u>150</u>
<u>Sand Mud</u>	<u>180</u>	<u>240</u>
<u>Mud Sand clay Stone</u>	<u>240</u>	<u>280</u>
<u>Mud Sand shale</u>	<u>280</u>	<u>280</u>

Information upon completion of well:

(1) Diameter 2 inches.

(2) Total Depth 285 feet.

(3) Water Level 87 feet below top of ground.

(4) Cased to _____, Size _____

(5) Screen: Size 007, Length 20

(6) Were any formations sealed against pollution?


_____ yes, no.

If YES depth of formation _____

Why _____

Drillers' Remarks: _____

CODED

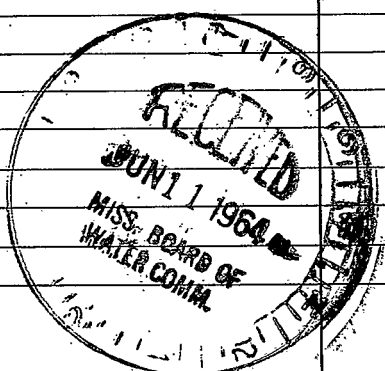

(Use Back Side)

Well No.

