

034
7-10-64

WATER WELL DRILLERS LOG

CODED

Date: 7/10, 1964, Driller: McKey County Madison
(Name)

COOPER

(1) Owner of Land: P. Cooper
(Name)
Canton Miss
(Address)

(2) Location: 1/4, 1/4, Sec. 27 T 9 R 4 E,
9 miles S.E. of Conover
(distance) (direction) (Nearest Town)

(3) Topography: (Hilly) (Flat) (Level)

(4) Purpose of Well: Home
(Domestic Irrigation, Municipal, Industrial, Other)

| Description & Color of Materials Sand, Clay, Red Clay, Shell, etc. | Thick- ness Feet | Depth Feet |
|---|------------------------|---------------|
| <u>Top Soil</u> | <u>0</u> | <u>10</u> |
| <u>Fine Sand</u> | <u>10</u> | <u>20</u> |
| <u>Fine Sand</u> | <u>20</u> | <u>30</u> |
| <u>Brown Clay</u> | <u>30</u> | <u>40</u> |
| <u>Clay</u> | <u>40</u> | <u>60</u> |
| <u>Sandy Clay</u> | <u>60</u> | <u>100</u> |
| <u>Sandy Clay</u> | <u>100</u> | <u>180</u> |
| <u>Fine Sand</u> | <u>180</u> | <u>200</u> |
| <u>Med Sand</u> | <u>200</u> | <u>240</u> |
| <u>Brown Shale</u> | <u>240</u> | <u>241</u> |

Information upon completion of well:

(1) Diameter 2 inches.

(2) Total Depth 240 feet.

(3) Water Level 106 feet below top of ground.

(4) Cased to _____, Size _____.

(5) Screen: Size 60 7, Length 10.


(6) Were any formations sealed against pollution?
_____ yes, no.

If YES depth of formation _____

Why _____

Drillers Remarks: _____

CODED

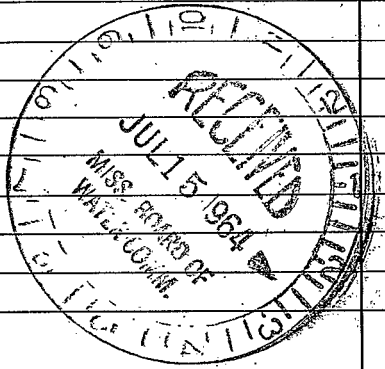

(Use Back Side)

Well No.

