

MADISON

MISSISSIPPI BOARD OF WATER COMMISSIONERS

⊕ 35

4-2-65

WATER WELL DRILLERS LOG

CODED

Date: 4/2/65, 19, Driller: M^c Kay County: Madison

(1) Owner of Land: ^{CMPI} Bostick
(Name)
Jackson Miss
(Address)

(2) Location: 1/4, 1/4, Sec. 26 T9 R9E,
11 miles S.E., of Centon
(distance) (direction) (Nearest Town)

(3) Topography: (Hilly) (Flat) (Level)

(4) Purpose of Well: Home
(Domestic Irrigation, Municipal, Industrial, Other)

Description & Color of Materials Sand, Clay, Red Clay, Shell, etc.	Thick- ness Feet	Depth Feet
Red sand	0	15
clay	15	20
Blue clay	20	40
Brown sandy clay	40	80
Blue clay	80	160
Blue clay	160	180
Brown sandy clay	180	200
" " "	200	220
Sandy clay - thin	220	240
" " "	240	260
fine sandy - clay str	260	280
med sand	280	300
med sand - clay str	300	320
med sand	320	340
med sand	340	350

Information upon completion of well:

(1) Diameter 2 inches.

(2) Total Depth 350 feet.

(3) Water Level 71 feet below top of ground.

(4) Cased to _____, Size _____

(5) Screen: Size 007, Length 20


(6) Were any formations sealed against pollution?
_____ yes, no.

CODED

If YES depth of formation _____

Why _____

Drillers Remarks: _____

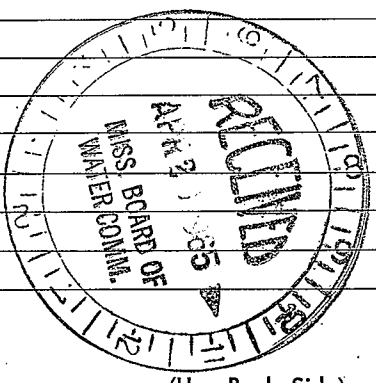

(Use Back Side)

Well No.

