

MADISON

WATER WELL DRILLERS LOG

CODED

Φ 36
Date: July 10, 1965, Driller: M. K. Kay
7-10-65

Name County Madison

(1) Owner of Land: Mamie Cox
(Name)
Sharon Miss
(Address)

(2) Location: 1/4, 1/4, Sec. 1 T9R9E
3 miles W of Farmhouse
(distance) (direction) (Nearest Town)

(3) Topography: (Hilly) (Flat) (Level)

(4) Purpose of Well: Home
(Domestic Irrigation
Municipal, Industrial, Other)

Description & Color of Materials Sand, Clay, Red Clay, Shell, etc.	Thick- ness Feet	Depth Feet
Top Soil	0	10
White Clay	10	20
White Sandy Clay	20	40
Blue clay	40	80
Blue clay	50	130
Blue Sand & Fine	140	160
Fine Sand, (Serpentine)	160	180
Fine Sandy Clay	180	200
Blue Clay Sand Sta	200	280
Brown Sandy clay	280	300
Blue Clay	300	420
Blue shale Rock Sta	420	480
Sand, Clay mixed	480	500
Fine Sand	500	520
Med to coarse Sand	520	580

Information upon completion of well:

(1) Diameter 2 inches.

(2) Total Depth 580 feet.

(3) Water Level 78 feet below top of ground.

(4) Cased to _____, Size _____

(5) Screen: Size 007, Length 20


(6) Were any formations sealed against pollution?
_____ yes, no.

If YES depth of formation _____

Why _____

Drillers Remarks: _____

air Pumping

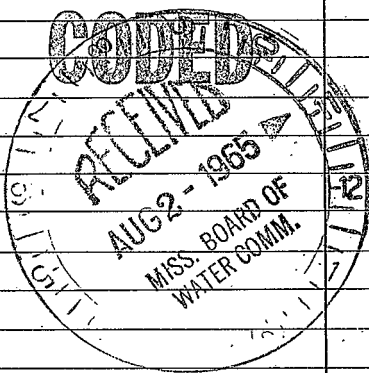

(Use Back Side)

Well No.

