

037

12-65

WATER WELL DRILLERS LOG

CODED

Date: Dec, 1965, Driller: M. Kay County Madison
(Name)

(1) Owner of Land: John Steen
(Name)
Carter Mine
(Address)

(2) Location: 18 93E
22 99E
1/4, Sec. T R

9 miles SE of Carter
(distance) (direction) (Nearest Town)

(3) Topography: ✓
(Hilly) (Flat) (Level)

(4) Purpose of Well: Home
(Domestic Irrigation
Municipal, Industrial, Other)

Description & Color of Materials Sand, Clay, Red Clay, Shell, etc.	Thick- ness Feet	Depth Feet
<u>White Clay</u>	<u>0</u>	<u>20</u>
<u>Blue Clay</u>	<u>20</u>	<u>40</u>
<u>Blue Clay</u>	<u>40</u>	<u>60</u>
<u>Fine Sand</u>	<u>60</u>	<u>100</u>
<u>Shale Sandy</u>	<u>100</u>	<u>220</u>
<u>Fine Sand</u>	<u>220</u>	<u>240</u>
<u>Med Sand</u>	<u>240</u>	<u>262</u>

Information upon completion of well:

(1) Diameter 2 inches.

(2) Total Depth 262 feet.

(3) Water Level 127 feet below top of ground.

(4) Cased to _____, Size _____

(5) Screen: Size 007, Length 10

(6) Were any formations sealed against pollution?
_____ yes, ✓ no.


CODED

air

If YES depth of formation _____

Why _____

Drillers Remarks: _____

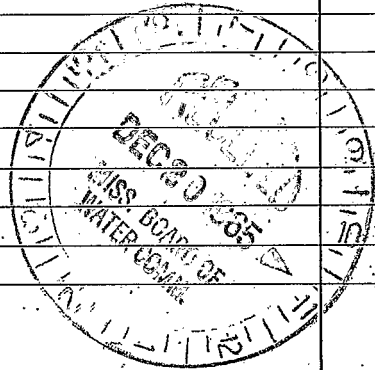

(Use Back Side)

Well No. _____

