

MADISON

Q 39

176-66

WATER WELL DRILLERS LOG CODED

Date: 7-6, 1966, Driller: J P Tharleton County Madison

(Name)

(1) Owner of Land: Vgene Perry
(Name)
Corton Miss
(Address)

(2) Location: 1/4, 1/4, Sec. 15 T9 R9E,
5 miles East, of Corton,
(distance) (direction) (Nearest Town)

(3) Topography: hilly
(Hilly) (Flat) (Level)

(4) Purpose of Well: Domestic
(Domestic Irrigation
Municipal, Industrial, Other)

Description & Color of Materials Sand, Clay, Red Clay, Shell, etc.	Thick- ness Feet	Depth Feet
<u>red clay</u>	<u>30</u>	
<u>green shale</u>	<u>75</u>	
<u>rock</u>	<u>2</u>	
<u>Black dirt</u>	<u>150</u>	
<u>rock</u>	<u>5</u>	
<u>Black sand</u>	<u>40</u>	
<u>sand + rock</u>	<u>5</u>	
<u>Water gassy fine sand</u>	<u>23</u>	
	<u>330</u>	


Information upon completion of well:

- (1) Diameter 2" inches.
- (2) Total Depth 330 feet.
- (3) Water Level 80 feet below top of ground.
- (4) Cased to 315', Size 2.
- (5) Screen: Size 1/4, Length 11 ft.
- (6) Were any formations sealed against pollution?
no

If YES depth of formation _____
Why _____

Drillers Remarks: 390 gal per hr.

CODED

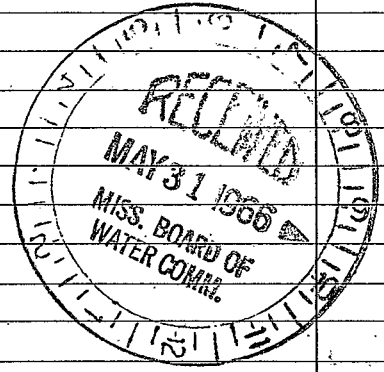

(Use Back Side)

Well No.

