

Ø40

WATER WELL DRILLERS LOG

CODED

7-29-66

Date: 7-29, 1966, Driller: J P Sheraton County: Madison

(Name)

(1) Owner of Land: Billy Davis
(Name)
Sherron miss
(Address)

(2) Location: 1/4, 1/4, Sec. 6 T 9 R 9E,
1 miles NE of Sherron,
(distance) (direction) (Nearest Town)

(3) Topography: X
(Hilly) (Flat) (Level)

(4) Purpose of Well: Domestic
(Domestic Irrigation
Municipal, Industrial, Other)

Description & Color of Materials Sand, Clay, Red Clay, Shell, etc.	Thick- ness Feet	Depth Feet
<u>Yellow Clay</u>	<u>68</u>	
dry sand	100	
<u>dry sand</u>	<u>100</u>	
<u>rock</u>	<u>3</u>	
<u>Water sand layer</u>	<u>149</u>	
	<u>220</u>	

CODED

Information upon completion of well:

(1) Diameter 2 inches.

(2) Total Depth 220 feet.

(3) Water Level 117 feet below top of ground.

(4) Cased to 205', Size 2"


(5) Screen: Size 1/4 SS, Length 6ft

(6) Were any formations sealed against pollution?
_____ yes, _____ no.

If YES depth of formation _____

Why _____

Drillers Remarks: 400 gal per hr

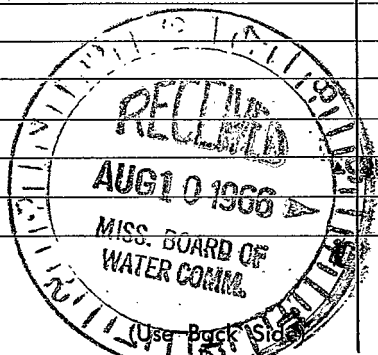

Well No.

