

MADISON

841

12-72

MISSISSIPPI BOARD OF WATER COMMISSIONERS
416 North State Street
Jackson, Mississippi 39201

CODED

WATER WELL DRILLERS LOG

Dec. 1972
date well completed

Thomas Saw
firm name

Madison
county well located

LANDOWNER: Milton Franklin

Canton, Miss.

(mailing address)

WELL LOCATION:

sec. 3 T 9 N R 4 E

7 1/2 miles NE of Canton
(distance) (direction) (nearest town)

WELL PURPOSE:

(home, irrigation, municipal, industrial)

WELL COMPLETION DATA:

- (1) diameter (inches) 2
- (2) total depth (feet) 231
- (3) static water level (feet) 30 below top of ground.
- (4) casing PVC, 221 (material) (depth)
2 (size) If telescope see back.
- (5) screen 10, 221 (length) (depth to top)
2" 8510 PVC (size) (material)
- (6) pump 1 Air 20 (HP) (yield gpm)
ebs. (type power)
- (7) electric log NO (yes or no)

(organization running log)

(8) how well bottom plugged fornt

description of formations encountered

from to

Red Dirt	0	15
Chalk Sand	15	24
Sticks Little Sand	24	105
Blue Chalk		
White Fine Sand	105	210
Mouse Sand	210	231

CODED


DRILLERS REMARKS:

MISS. BO. OF WATER COMMISSIONERS

JAN 3 1973

If well telescopes please sketch and show depths.

GROUND LEVEL

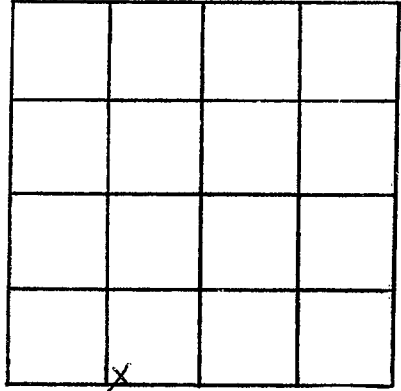

SECTION 3

Please indicate well location X.

ADDITIONAL INFORMATION

If more than one screen,
show locations of each on sketch.