

MADISON

042

1-73

MISSISSIPPI BOARD OF WATER COMMISSIONERS 416 North State Street Jackson, Mississippi 39201

CODED

WATER WELL DRILLERS LOG

TAD 1973 date well completed

Thompson firm name

Madison county well located

LANDOWNER: H. H. Holcomb

Canton, Miss.

(mailing address)

WELL LOCATION:

sec. 33 T. 9 N. R. 4 E. 6 1/2 miles S.E. of Canton (distance) (direction) (nearest town)

WELL PURPOSE:

(home, irrigation, municipal, industrial)

WELL COMPLETION DATA:

- (1) diameter (inches) 2
(2) total depth (feet) 187
(3) static water level (feet) 92 below top of ground
(4) casing PVC 182 (material) (depth)
(5) screen 5 182 (length) (depth to top)
2" 8 slot PVC (size) (material)
(6) pump 1 5 (HP) (yield gpm)
Elec. (type power)
(7) electric log NO (yes or no)

(organization running log)

(8) how well bottom plugged point

description of formations encountered

from to


Table with 3 columns: description of formations encountered, from, to. Rows include: fine clay (0-18), sand (18-22), yellow chalk (22-25), blue chalk (25-95), little str's sand & chalk (95-105), grey chalk (105-120), sand coarse (120-187), AT BOTTOM.

CODED

DRILLERS REMARKS:

If well telescopes please sketch and show depths.

GROUND LEVEL

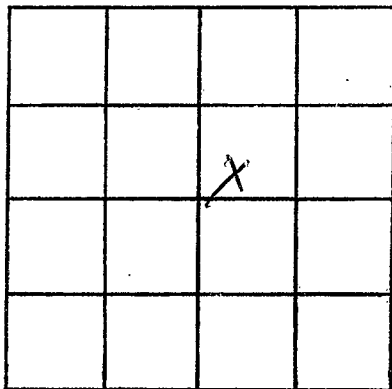

SECTION

33

Please indicate well location X.

ADDITIONAL INFORMATION

If more than one screen,
show locations of each on sketch.