

MADISON  
 043  
 11/23/78  
 File # 249

MISSISSIPPI  
 BOARD OF WATER COMMISSIONERS  
 416 North State Street  
 Jackson, Mississippi 39201

CODED

WATER WELL DRILLERS LOG

Nov. 23 1978 E.M. "Bud" Cresswell Madison  
 date well completed firm name county well located

LANDOWNER:  
 David K. Brooks  
 CANTON, MS.  
 (mailing address)

description of formations encountered	from	to
Clay	0	80
Hard Iron Shells	80	120
Gravel	120	200
Sand	200	450

WELL LOCATION:  
 sec. 29 T. 9 N. R. 4 E.  
 6 miles EAST of CANTON  
 (distance) (direction) (nearest town)

WELL PURPOSE: Home  
 (home, irrigation, municipal, industrial)

CODE


- WELL COMPLETION DATA:
- (1) diameter (inches) 4
  - (2) total depth (feet) 450
  - (3) static water level (feet) 130 below top of ground.
  - (4) casing PVC, 420 (material), (depth)  
 4 (size) if telescope see back.
  - (5) screen 30, 420 (length), (depth to top)  
 4, PVC (size), (material)
  - (6) pump 15, 30 (HP), (yield gpm)  
 0 (type power)
  - (7) electric log Yes (yes or no)  
 Hall (organization running log)
  - (8) how well bottom plugged  
 Steel plugs

DRILLERS REMARKS:

RECEIVED  
 DEC - 5 1978

If well telescopes please sketch and show depths.

GROUND LEVEL

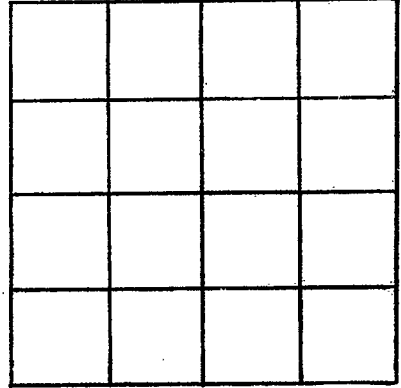

SECTION \_\_\_\_\_

Please indicate well location X.

ADDITIONAL INFORMATION

If more than one screen, show locations of each on sketch.