

MISSISSIPPI DEPARTMENT OF NATURAL RESOURCES

Bureau of Land and Water Resources

Southport Mall

CODED

P.O. Box 10631

Jackson, Mississippi 39209

WATER WELL DRILLERS LOG

MADISON
Ø 44
5-12-81

5-12-81 *Lerner Drilling Service, Inc* *Madison*
 date well completed firm name county well located

LANDOWNER:	description of formations encountered	from	to
<i>Shell Oil Company</i>	<i>clay</i>	<i>0</i>	<i>240</i>
<i>P.O. Box 61555</i>	<i>sand</i>	<i>240</i>	<i>273</i>
<i>New Orleans, La</i> (mailing address)	<i>clay</i>	<i>273</i>	<i>613</i>
WELL LOCATION: <i>1846 N + 2327 W</i>	<i>sand</i>	<i>613</i>	<i>799</i>
<i>#1 Canton Exchange Bank</i> <i>31 T 9 S R 4 E of W 3640</i>	<i>clay</i>	<i>799</i>	<i>812</i>
<i>Canton</i> of <i>Canton</i> (nearest town)			
WELL PURPOSE: <i>oil field supply</i>			
(home, irrigation, municipal, industrial)			

- WELL COMPLETION DATA:
- (1) diameter (inches) *4"*
 - (2) total depth (feet) *812'*
 - (3) static water level (feet) *160'* below top of ground.
 - (4) casing *steel 777'*
(material) (depth)
4" if telescope see back.
(size)
 - (5) screen *42'*, *735'*
(length) (depth to top)
4", *perforated*
(size) (material)
 - (6) pump *70*
(HP) (yield gpm)
ac
(type power)
 - (7) electric log *(yes or no)*
(organization running log)
 - (8) how well bottom plugged *orange peel*


CODED



DRILLERS REMARKS:

If well telescopes please
sketch and show depths.

GROUND LEVEL

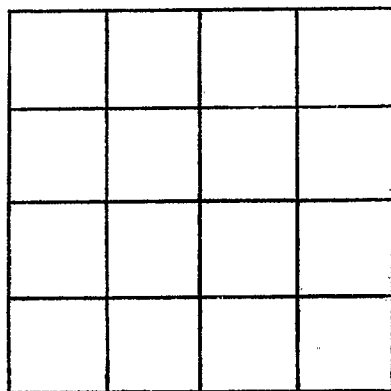

SECTION _____

Please indicate well location X.

ADDITIONAL INFORMATION

If more than one screen,
show locations of each on sketch.