

MISSISSIPPI DEPARTMENT OF NATURAL RESOURCES

Bureau of Land and Water Resources

Southport Mall

P.O. Box 10631

Jackson, Mississippi 39209

WATER WELL DRILLERS LOG

MADISON
Ø 4.5
9/30/82

Griner Drilling Service, INC.

Madison

9-30-82 date well completed

Griner Drilling Service, INC. firm name

Madison county well located

LANDOWNER:	description of formations encountered	from	to
Shell Oil Company P.O. Box 61555 New Orleans, La. 70160 (mailing address)	Sand, clay	0	310
WELL LOCATION: 2500' N & 1500' E Sec. 34 T. 9 N R. 4 E SW/4 No. 1 Hauberg Canton of 1/4 miles (distance) (direction) (nearest town)	Sand	310	399
WELL PURPOSE: oilfield supply (home, irrigation, municipal, industrial)	clay	399	441
WELL COMPLETION DATA:			
(1) diameter (inches) 4"	CODED		
(2) total depth (feet) 441'			
(3) static water level (feet) 100' below top of ground.			
(4) casing Steel, 399' (material) (depth) 4" if telescope see back. (size)			
(5) screen 42' 357' (length) (depth to top) 4" perforated (size) (material)			
(6) pump — 85 (HP) (yield gpm) AC (type power)			
(7) electric log — (yes or no) (organization running log)			
(8) how well bottom plugged Orange peel			
DRILLERS REMARKS:			


DEPT. OF NATURAL RESOURCES
BUREAU OF LAND & WATER RESOURCES

OCT 25 1982

RECEIVED

If well telescopes please sketch and show depths.

GROUND LEVEL

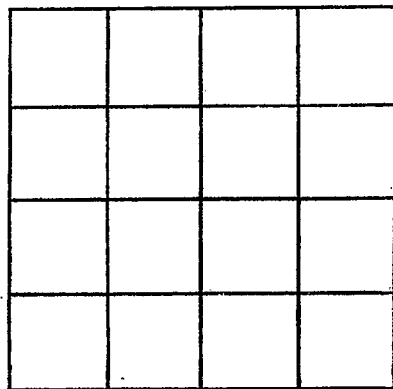

SECTION _____

Please indicate well location X.

ADDITIONAL INFORMATION

If more than one screen,
show locations of each on sketch.