

MADISON
2001

MISSISSIPPI
BOARD OF WATER COMMISSIONERS
416 North State Street
Jackson, Mississippi 39201

4-11-80

WATER WELL DRILLERS LOG

4-11-80 date well completed
Thomas Brown firm name
Madison county well located

LANDOWNER: W.D. Pierce
Rt. 1, Ft. Ferry
Canton, MS.
(mailing address)

description of formations encountered	from	to
D.V. chalk	0	15
SAND	15	28

WELL LOCATION:
sec. 25 T 9 N R 14 E
S W
9 1/2 miles E of Canton
(distance) (direction) (nearest town)

WELL PURPOSE:
Camp (home, irrigation, municipal, industrial)

- WELL COMPLETION DATA:
- (1) diameter (inches) 2
 - (2) total depth (feet) 28
 - (3) static water level (feet) 14 ^{below} _{above} top of ground.
 - (4) casing PVC, 23 (material) (depth)
2 (size) if telescope see back.
 - (5) screen 5, 23 (length) (depth to top)
2, 8 slot PVC (size) (material)
 - (6) pump 2, 15 (HP) (yield gpm)
Elec (type power)
 - (7) electric log No (yes or no)

(8) how well bottom plugged Perched
(organization running log)

DRILLERS REMARKS:


DEPT. OF NATURAL RESOURCES
BUREAU OF LAND & WATER RESOURCES

APR 21 1980

RECEIVED

If well telescopes please sketch and show depths.

GROUND LEVEL

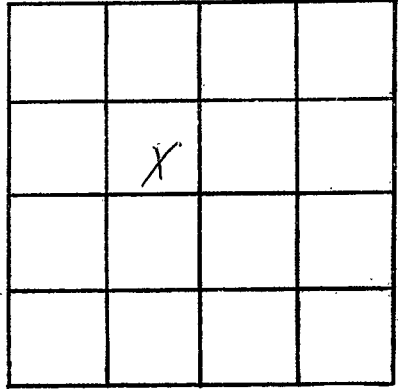

SECTION 25

Please indicate well location X.

ADDITIONAL INFORMATION

If more than one screen,
show locations of each on sketch.