

MADISON
P 7
3-16-73

MISSISSIPPI
 BOARD OF WATER COMMISSIONERS
 416 North State Street
 Jackson, Mississippi 39201

WATER WELL DRILLERS LOG

3-16 1973 Thomas & Son MADISON
 date well completed firm name county well located

LANDOWNER: HAL DEAN description of formations encountered from to
JACKSON, MISS fine Clay & Chalk 0 25
Coarse white sand 25 42

(mailing address)
 WELL LOCATION:
 sec. 19 T. 9 N. R. 5 E
10 miles E of CANTON
 (distance) (direction) (nearest town)

WELL PURPOSE: CAMP HOUSE
 (home, irrigation, municipal, industrial)

WELL COMPLETION DATA:
 (1) diameter (inches) 2
 (2) total depth (feet) 42
 (3) static water level (feet) 12 below above top of ground.
 (4) casing PVC 37
 (material) (depth)
1 1/4 if telescope see back.
 (size)
 (5) screen 5 37
 (length) (depth to top)
2" 85/100 PVC
 (size) (material)
 (6) pump 1/3 10
 (HP) (yield gpm)
Electric
 (type power)
 (7) electric log NO
 (yes or no)
 (organization running log)
 (8) how well bottom plugged point


CODED

JUN 11 1973

DRILLERS REMARKS:

If well telescopes please sketch and show depths.

GROUND LEVEL

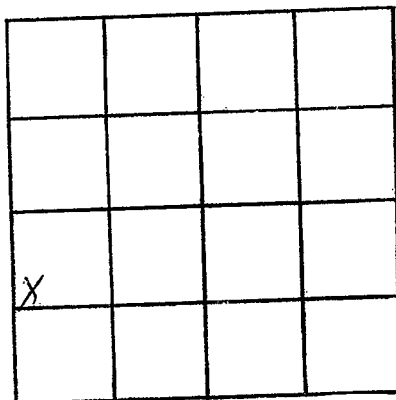

SECTION 19

Please indicate well location X.

ADDITIONAL INFORMATION

If more than one screen, show locations of each on sketch.