

PS
 MADISON
 8-73

MISSISSIPPI
 BOARD OF WATER COMMISSIONERS
 416 North State Street
 Jackson, Mississippi 39201

CODED

WATER WELL DRILLERS LOG

Aug 24 1973 *Thompson* *Madison*
 date well completed firm name county well located

LANDOWNER: *John Simon*
Canton, Miss

description of formations encountered	from	to
	<i>Pipe clay</i>	<i>0</i>
<i>course sand</i>	<i>15</i>	<i>30</i>

(mailing address)

WELL LOCATION:
 sec. *19* T. *9* N. R. *5* E.

miles of (distance) (direction) (nearest town)

WELL PURPOSE:
 (home, irrigation, municipal, industrial)

WELL COMPLETION DATA:

- (1) diameter (inches) 2
- (2) total depth (feet) 30
- (3) static water level (feet) 17 ^{below} top of ground.
- (4) casing *pc* 24
 (material) (depth)
2 if telescope see back.
 (size)
- (5) screen 6 24
 (length) (depth to top)
2" 8 slot *pc*
 (size) (material)
- (6) pump 1/2 7
 (HP) (yield gpm)
elk
 (type power)
- (7) electric log *no*
 (yes or no)
 (organization running log)
- (8) how well bottom plugged *lo. int*


CODED

DRILLERS REMARKS:

AUG 24 1973

If well telescopes please
sketch and show depths.

GROUND LEVEL

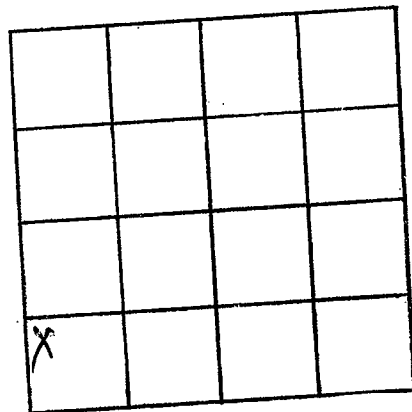

SECTION 19

Please indicate well location X.

ADDITIONAL INFORMATION

If more than one screen,
show locations of each on sketch.