

P

2000

WATER WELL DRILLERS LOG

Date: 10-10, 1978, Driller: Thomas & Son County: Madison  
(When well drilled) (Name) (Where well is located)

(1) Owner of Land: Pool  
(Name)  
Canton, Ms.  
(Address)  
(2) Location: 1/4, 1/4, Sec. 5 TRS  
11 miles NE of Canton  
(distance) (direction) (Nearest Town)  
(3) Topography: (Hill) (Flat) (Level)  
(4) Purpose of Well: Domestic Irrigation  
Municipal, Industrial, Other

Description & Color of Materials Sand, Clay, Red Clay, Shell, etc.	Thick- ness Feet	Depth Feet
HARD DIRT	•	5
White CHALK	5	35
Grey CHALK	35	65
Silty Fine SAND & CHALK	65	136
Fine SAND	136	170
Good SAND	170	180
STRS SAND & CHALK	180	191

Information upon completion of well:


(1) Diameter 2 inches.  
(2) Total Depth 191 feet.  
(3) Water Level 90 feet below top of ground.  
(4) Cased to 171, Size 2  
(5) Screen: Size 3/8" x 2", Length 20 FT. PIC  
(6) Were any formations sealed against pollution?  
yes, no.

If YES depth of formation  
Why

Drillers Remarks: Pool  
Yield in gpm: 20-24.0  
Size pump: Air Compressor  
Type power: Elec.

RECEIVED  
OCT 17 1978

MISS. BD. OF WATER COMM

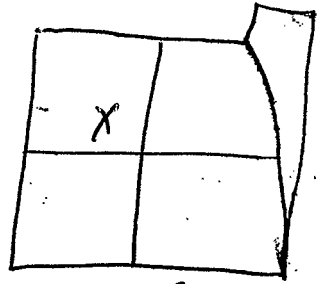

5